

SURVEY & REMONUMENTATION

APPROVED LAND CORNER
P.A. 345 OF 1990
MIDLAND COUNTY

APR 28 1995

152

COMMISSION LAND CORNER RECORDATION CERTIFICATE Filing Requirement of Act 74, Mich. P.A. 1970

STATE OF MICHIGAN
MIDLAND COUNTY
REMONUMENTATION & FILED

11/28/94 JSG

For corners in

7 DEC 94 8:23 A.M.

BEVERLY J THAYER
REGISTER OF DEEDS

MIDLAND (County)	Located In:	Corner Code #
1. Public Land Survey	T 16NR 2E	L-11
	T R	
	T R	
	T R	
2. Property Controlling in Section	S T R	
	S T R	
3. Miscellaneous Property in Sec.	S T R	
	S T R	

Register of Deeds Stamp & File Number

4. Lot No. _____, Recorded Plat _____
5. Private Claims _____

I, PAUL B. LAPHAM, in a field survey on JUNE, 19 94, do hereby certify that under requirements of P.A. 74, Michigan P.A. of 1970, the corner points mentioned in lines 1 and 2 above were in conformance with regulations and rules therefore as required in the current manual of survey instructions of the United States Department of the Interior, Bureau of Land Management or by a decree of a Court of Law and/or that the corner points mentioned in lines 3, 4 and 5 above were in conformance with the rules of the Michigan Board of Land Surveyors or by a Decree of a Court of Law; established, re-established, monumented, re-monumented, recovered, found as expressed below:

NOTE: Not more than 4 corners, all in the same town and range, may be recorded on this certificate.

	A	B	C	D	E	F	G	H	I	J	K	L
2	6		5		4		3		2			
3												
4	7		8		9		10		11			
5												
6	18		17		16		15		14			
7												
8	19		20		21		22		23			
9												
10	30		29		28		27		26			
11												
12	31		32		33		34		35			
13												

A. Description of original monument and accessories and/or subsequent restoration:

L-11: 1/4 Corner common to Sections 25 & 36
1831 - Harvey Parke Maple 6" S 57°E 22 lks
No C.S.R.
7-17-71 - Alva Courtwright, Set 3/4" x 18" rod as req'd by B.L.M. (S.P.M.) Set Mon. Box over Corner L.C.R.C.#10
1. NE 77.5' 20" Oak, 2. SE 25.3' U.S.G.S. Marker L.C.R.C. 106
8-19-74 - Paul Lapham, Found 3/4" Bar in Mon. Box (132) 1-706
1. N 40°E 77.36' 24" Oak, 3. N 15°E 73.54' 16" Oak, 2. S 05°E 25.20' U.S.G.S. Marker
11-6-74 - Paul Lapham, Same as above L.C.R.C. 332
5-15-78 - Edmonds Eng., Found 5/8" Iron in Mon. Box (132) 2-614
4. S 2.5' S edge Bit. Road, 5. NE 101.5' face, 14" Oak, 2. S 05°E 25.18' U.S.G.S. Marker in fence corner
12-87 - Ledy Eng., Found 1/2" Rod in Mon. Box (132) 4-176 & 177 (132) 4-582 & 583
6. N 8.8' Road, 7. N 38.55' Spike in 8" Elm, 8. N 45°W Spike in 6" Poplar, 2. S 02°E 6" BM in conc.

B. Description of corner evidence found and/or method applied in restoring or reestablishing corner:


L-11: 1/4 Corner common to Sections 25 & 26
Found 3/4" x 18" Pipe over 3/4" x 18" Rod in Mon. Box. Did not find further evidence.
Found recorded witnesses 1, 2, 3, 4, 5, 6 & 7.

Accepted as best available evidence of the position of the original corner & replaced with Standard Monument.

Corner L-11 was approved for remonumentation at a Peer Review Committee Meeting on Nov. 28, 1994.

C. Description of monument for corner and accessories established to perpetuate locating the position of the corner:

L-11: 1/4 Corner common to Sections 25 & 26
Set 5/8" x 36" re-rod with brass cap stamped "Midland Co. Remon. Cor. PS 9433" in Mon. Box.
S 02°E, 25.20' - U.S.G.S. Benchmark (2)
NORTH, 38.55' - Spike in 10" Elm (7)
N 43°E, 77.85' - Spike in 24" Oak (1)
N 45°W, 50.56' - Spike in 6" Poplar

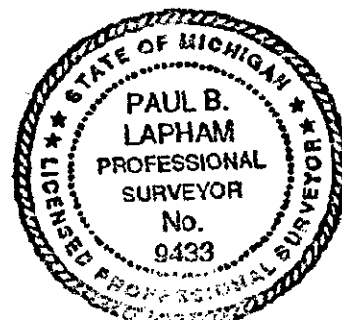

Signed by Paul B. Lapham Date 12-05-94

Surveyor's Michigan License No. 9433