

MAY 20 1997

LAND CORNER RECORDATION CERTIFICATE
Filing Requirement of Act 74, Mich. P.A. 1970

RECEIVED FOR RECORD

96 NOV 22 PM 2:38

For corners in COMMISSION

MONROE (58)
(County)

Located In:

Corner Code #

1. Public Land Survey

T R

T R

FRENCHTOWN TWP.

T 6S R 9E

T R

A-3

2. Property Controlling
in Section

S T R

S T R

3. Miscellaneous
Property in Sec.

S T R

S T R

4. Lot No. Recorded Plat

5. Private Claims

GEORGE B. WARNKE, JR. - 1996 CORNER

I, G.B. WARNKE, JR., in a field survey on 1995 & 1996, 19 do hereby certify that under requirements of P.A. 74, Michigan P.A. of 1970, the corner points mentioned in lines 1 and 2 above were in conformance with regulations and rules therefore as required in the current manual of survey instructions of the United States Department of the Interior, Bureau of Land Management or by a decree of a Court of Law and/or that the corner points mentioned in lines 3, 4 and 5 above were in conformance with the rules of the Michigan Board of Land Surveyors or by a Decree of a Court of Law; established, re-established, monumented, re-monumented, recovered, found as expressed below:

NOTE: Not more than 4 corners, all in the same town and range, may be recorded on this certificate.

A. Description of original monument and accessories and/or subsequent restoration:

1817, GLO Surveyor, J. Fletcher, Intersect W. Boundary & set post - witnesses:

B. Oak 12 S60E 61 & W. Oak 12 N34E 93

July & Aug., 1967, Macay for Detroit Edison field notes show "Not Fd." & drawing shows "Set R.R. Spike".

6/1968, A.J. Marino field notes show "F. Iron".

10/18/76, A.J. Marino field notes "F.I. Rod" - witnesses:

Northeasterly 172.50' nail in tel. pole

Southeasterly 83.62' nail in tel. pole

Westerly 26.56' tacked wood hub

Section A continued on reverse side

B. Description of corner evidence found and/or method applied in restoring or reestablishing corner:

8/30/95 G.B. Warnke crew found 5/8" x 30" iron rebar 11 inches below surface. Dug a 20" x 24" hole. No further evidence found. Set a 1" x 36" iron pipe inside monument box to place rebar.

9/24/1996, corner was approved by Remonumentation Peer Group - reference corner dossier for further info.

10/16/1996, set brass cap on existing 1" iron pipe in mon. box.

Section Corner common to Sections 6 & 7 / On Exeter Road being 4" asphalt surface over mixed stone.

C. Description of monument for corner and accessories established to perpetuate locating the position of the corner:

Set 1" x 36" iron pipe with brass remonumentation cap in monument box to replace found 5/8" iron rebar and is accepted as the best available evidence of the position of the original corner and witnesses:

N25°E 173.81 feet to set nail & shiner in west face of cable pole

S35°E 79.94 feet to set nail & shiner in west face of cable pole

S85°W 29.77 feet to nail & shiner in east face of multiple truck Oak

North 460.88 feet to 1 inch I. pipe in monument box (M-2, T6S, R8E)

RATIFIED BY PEER GROUP

PA 345 OF 1990

MONROE COUNTY, MICHIGAN

date: 9/24/1996

County Rep.: [Signature]

Signed by

Date


10/21/1996

Surveyor's Michigan

License No. NO.

19474

GEORGE B. WARNKE

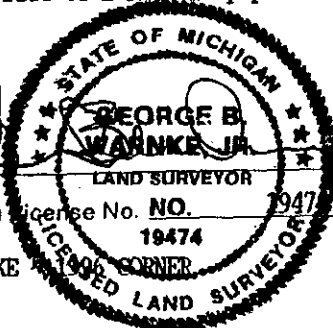

SURVEY &
REMONUMENTATION

MAY 20 1997

LIREN

4 PAGE 173

COMMISSION

Section A Continued From Front Side

8/30/95, George B. Warnke survey drawing (#89-555) notes "set 1" x 36" I. pipe inside mon. box in place of 5/8" I. rebar" - witnesses: N25°E 173.81 feet to set nail & shiner in west face of cable pole
S35°E 79.94 feet to set nail & shiner in west face of cable pole
S85°W 29.77 feet to nail & shiner in east face of multiple truck Oak
North 460.88 feet to 1 inch I. pipe in monument box (M-2)