

date: 10/24/95

County Rep.:                     

LAND CORNER RECORDATION CERTIFICATE  
Filing Requirement of Act 74, Mich. P.A. 1970

For corners in  
Monroe (58)

(County)

Located In:

Corner Code #

1. Public Land Survey  
Frenchtown Twp.

T 6S R 9E

C-2

2. Property Controlling  
in Section

S        T        R       

3. Miscellaneous  
Property in Sec.

S        T        R       

SURVEY &  
REMONUMENTATION

Register of Deeds Stamp & File Number

APR 04 1996

4. Lot No.                     , Recorded Plat                     

5. Private Claims                     

COMMISSION

Submitted by George B. Warnke, Jr. / MCRC Project

G.B. WARNKE, JR., in a field survey on 1993 - 1995, 19       ,  
do hereby certify that under requirements of P.A. 74, Michigan P.A. of 1970, the corner points mentioned  
in lines 1 and 2 above were in conformance with regulations and rules therefore as required in the  
current manual of survey instructions of the United States Department of the Interior, Bureau of Land  
Management or by a decree of a Court of Law and/or that the corner points mentioned in lines 3, 4 and 5  
above were in conformance with the rules of the Michigan Board of Land Surveyors or by a Decree of a  
Court of Law; established, re-established, monumented, re-monumented, recovered, found as  
expressed below:

NOTE: Not more than 4 corners, all in the same town and range, may be recorded  
on this certificate.

A. Description of original monument and accessories and/or subsequent restoration:

1/4 Corner common to Sections 5 & 6 / On Toben Road being west of South Stoney Creek Road on hard surface.  
1817, GLO Surveyor, J. Fletcher, south between Sec. 5 & 6, set qr. Sec. post - witnesses: W. Oak 20 N.66W  
18 & W. Oak 1.2 N.64E. 36. A.J. Marino: 1960 field notes show F.I. and survey shows FOUND IRON & 1963,  
1964, 1966, 1969, 1972 & 1973 field notes show F.I., 1972 field notes show 3/4" old iron pipe. M.R. Fleck:  
1973 survey, recorded in Liber 650, Page 487, shows FOUND IRON & 1973 survey, recorded in Liber 654, Page  
264, shows F.I.P. & 1973 survey, File No. 17714, shows F.I.P. & 1978 surveys, recorded in Liber 791, Page 815  
& Liber 791, Page 821, shows FD IP & 1979 survey, recorded in Liber 794, Page 586, shows F. IRON.  
G.B. Warnke: 1986 survey (#86-15) shows FOUND IRON PIPE & 1989 survey (#89-583) notes FD. 1/2" I. PIPE &  
1994 survey (#86-015) notes FOUND 1/2" REBAR.


B. Description of corner evidence found and/or method applied in restoring or reestablishing corner:

1993 - Found 1/2" rebar; no further evidence found; witnessed as shown below. (Warnke crew talked to MCRC  
survey crew that indicated that they excavated both B-2 & C-2 and did not find any further evidence.)  
1994 - Monroe County Road Commission set monument box around found 1/2" rebar. 1995 - G.B. Warnke crew set  
1" X 36" iron pipe with brass remonumentation cap in existing monument box.

C. Description of monument for corner and accessories established to perpetuate locating the position of the corner:

Set 1" X 36" iron pipe with brass remonumentation cap in existing monument box and  
is accepted as the best available evidence of the position of the original corner and  
witnesses:

South 10° West 83.93 feet to northeast corner of block telephone building #LA-1/2S  
South 15° West 85.55 feet to northwest " " " " "  
North 45° West 125.21 feet to southeast corner of grey two story house (no house #)  
South 15° East 85.35 feet to northwest corner of house #1905  
South 40° East 101.27 feet to northeast " " "

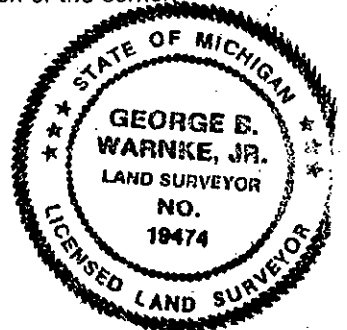

Signed by                     

Date 12/27/1995

Surveyor's Michigan License No. 19474

Submitted by G.B. Warnke, Jr., P.S.