

SURVEY & REMONUMENTATION

DEC 1 5 1986

LAND CORNER RECORDATION CERTIFICATE
Filing Requirement of Act 74, Mich. P.A. 1970

RECEIVED FOR RECORD

96 SEP -6 PM 1:54

For corners in

MONROE

(County)

Located In:

Corner Code #

1. Public Land Survey
SUMMERFIELD TWP.

T 7S R 6E

K-13

2. Property Controlling
in Section

S T R

3. Miscellaneous
Property in Sec.

S T R

4. Lot No. , Recorded Plat

5. Private Claims

George B. Warnke Corner

I, G.B. WARNKE, JR., in a field survey on 1995 & 1996, 19 do hereby certify that under requirements of P.A. 74, Michigan P.A. of 1970, the corner points mentioned in lines 1 and 2 above were in conformance with regulations and rules therefore as required in the current manual of survey instructions of the United States Department of the Interior, Bureau of Land Management or by a decree of a Court of Law and/or that the corner points mentioned in lines 3, 4 and 5 above were in conformance with the rules of the Michigan Board of Land Surveyors or by a Decree of a Court of Law; established, re-established, monumented, re-monumented, recovered, found as expressed below.

NOTE: Not more than 4 corners, all in the same town and range, may be recorded on this certificate.

- A. Description of original monument and accessories and/or subsequent restoration:

1819, G.L.O Surveyor, Joseph Fletcher, set post corner of Section 35 & 36 - Witnessed: Elm 20 S51°W
200 lks & W. Oak 16 S29°W 286 lks;
1900, L.A. Howard found stake;
1904, L.A. Howard found stake;
1974, G.B. Warnke set 3/4" sq. iron pin 81.08 chains west of M-13 (Fd. I. Pipe); 1974, G.B. Warnke, Survey No. 74-59 states found 3/4" sq. I. pin;
1993, J.C. Andrus survey No. 93S-6908 notes found bolt.

- B. Description of corner evidence found and/or method applied in restoring or reestablishing corner:

1994 and 1995, G.B. Warnke field crew found 3/4" sq. head iron harrow tooth.
2/27/1996, corner approved by Remonumentation Peer Group (see dossier for more information).
8/15/1996, G.B. Warnke crew set 1" x 36" iron pipe with remonumentation cap in monument box to replace harrow tooth. No other evidence or metallic readings were found when excavating to set box, iron & cap.

RATIFIED BY PEER GROUP
PA 345 OF 1990
MONROE COUNTY, MICHIGAN
date: 2/27/1996
County Rep.: [Signature]

- C. Description of monument for corner and accessories established to perpetuate locating the position of the corner:


Set 1" x 36" iron pipe with remonumentation cap in monument box to replace found and is accepted as the best available evidence of the position of the original corner and witnessed:
North 45° East 39.13 feet to east end of 15" concrete culvert
North 45° West 61.48 feet to found car coin/nail in southeast face of telephone pole.
South 70° West 121.72 feet to set nail/tag in north face 12 inch tree
South 45° East 226.21 to set nail/tag in south face electric pole

Signed by

Date 8 / 22 / 1996

Surveyor's Michigan License No 19474

G.B. Warnke Corner / 94-0076 & 95-0036

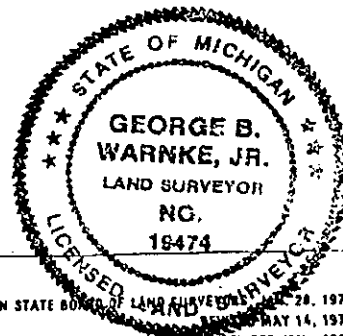

FORM APPROVED BY MICHIGAN STATE BOARD OF LAND SURVEYORS, MAY 14, 1971, REVISED JAN., 1980