

SURVEY & REMONUMENTATION

FEB 13 1998

SECTION

LAND CORNER RECORDATION CERTIFICATE Filing Requirement of Act 74, Mich. P.A., 1970

For corners in

Monroe (58)

(County)

Located In:

Corner Code #

WHITEFORD TWP.

1. Public Land Survey

T8S R6E

I-5

2. Property Controlling
in Section

S T R

3. Miscellaneous
Property in Sec.

S T R

S T R

4. Lot No. _____, Recorded Plat _____

5. Private Claims _____

1997 G.B. Warnke Remonumentation Private Corner

I, George B. Warnke, Jr., in a field survey on September 18, 1997 do hereby state that under requirements of P.A. 74, Michigan P.A. of 1970, the corner points mentioned in lines 1 and 2 above were in conformance with regulations and rules therefore as required in the current manual of survey instructions of the United States Department of the Interior, Bureau of Land Management or by decree of a Court of Law and / or that the corner points mentioned in lines 3, 4 and 5 above were in conformance with the rules of the Michigan Board of Land Surveyors or by a Decree of a Court of Law; established, re-established, monumented, recovered, found as expressed below:

NOTE: Not more than 2 corners, all in the same town and range, may be recorded on this certificate.

A. Description of original monument and accessories and/or subsequent restoration:

- 1820 GLO, Joseph Wampler, set post corner of Secs. No. 10, 11, 14 & 15 from which a W. Oak 25 ins. dia. bears N47E 35 lks. dis. & a Poplar 9 ins. dia. bears S77W 30 lks. dis.
- 1965 Michigan State Highway Department, Jerry L. Wilcox, witness card notes ¾" pipe from witnesses furnished by Mr. M. Fleck, Temperance, Michigan, One witnesses shown on highway plans, Proj. 58-56, File # V-41-I, and Gov't corner on above plans checked its' location.
- 1972 Case & Fleck surveys notes PK nail & F. nail
G.B. Warnke surveys note PK nail over I.P. & I. Pipe
- 1975 G.B. Warnke survey notes PK nail over I. Pin
- 1976 G.B. Warnke survey notes PK nail over I.P.
- 1978 Case & Fleck survey notes Fd. Iron
- 1982 G.B. Warnke survey notes set R.R. spike over I. Pipe
- 1985 G.B. Warnke survey used corner
- 1989 G.B. Warnke survey notes iron found
- 1994 G.B. Warnke survey found railroad spike

B. Description of corner evidence found and/or method applied in restoring or re-establishing corner:

September 18, 1997, G.B. Warnke found RR spike at surface over ¾" x 24" pipe at 8" deep. Location of corner at Whiteford Center Road & Erie Road being in 4" asphalt over 8" stone over sand. During excavation, dug a 24" x 24" hole & probed with no other evidence found. Set 1" x 36" pipe in monument box to replace found RR spike over ¾" pipe.

RATIFIED BY PEER GROUP, PA 345 OF 1990, MONROE COUNTY, MICHIGAN, DATE 11/18/1997, COUNTY REP.

12/1/1997, G.B. Warnke set brass remonumentation cap on previously set 1" x 36" pipe in monument box.

C. Description of monument for corner and accessories established to perpetuate locating the position of the corner:

Set 1" x 36" pipe with brass remonumentation cap in monument box and is accepted as the best available evidence of the position of the original corner. Witnesses:
North 37° East 39.67 feet to found nail & shiner in northwesterly face of utility pole
North 57° East 43.04 feet to found nail & shiner in northwesterly face of telephone pole
South 40° East 39.60 feet to found nail & washer in southwesterly face of utility pole
North 49° West 37.15 feet to found nail & washer in southwesterly face of telephone pole

Signed by

[Signature]

Date December 3, 1997

Surveyor's Michigan License No. 19474




LIRER

4 Feb. 339

Ken Allen
REGISTER OF DEEDS
MONROE COUNTY, MICH

RECEIVED FOR RECORD
97 DEC 30 PM 3:18

Register of Deeds Stamp & File Number

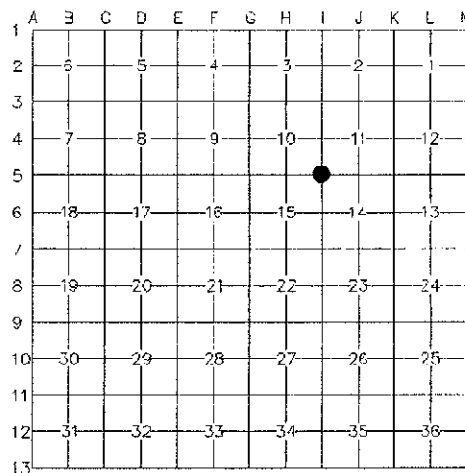

[Signature]

FORM APPROVED BY MICHIGAN STATE BOARD OF LAND SURVEYORS, JAN. 28, 19'
REVISED MAY 14, 19'
REVISED JAN., 19'
REVISED OCT., 19'