

RATIFIED BY PEER GROUP
PA 345 OF 1990
MONROE COUNTY, MICHIGAN

date: 10/25/94
County Rep.: Bruce Antcliff

LAND CORNER RECORDATION CERTIFICATE
Filing Requirement of Act 74, Mich. P.A. 1970

For corners in

Monroe
(County)

Located In:

Corner Code #

1. Public Land Survey
Whiteford Twp.

T 9S R 6E

B-1

T 9S R 6E

T 9S R 6E

SURVEY &

REMONUMENTATION

2. Property Controlling
in Section

S 9S T 6E

T 9S R 6E

3. Miscellaneous
Property in Sec.

S 9S T 6E

T 9S R 6E

APR 04 1996

Register of Deeds Stamp & File Number

COMMISSION

4. Lot No. , Recorded Plat

5. Private Claims

G.B. Warnke & Monroe Co. Road Commission Corner

Bruce Antcliff

12/20

95

I, G.B. Warnke, in a field survey on Sept 1994, do hereby state that under requirements of P.A. 74, Michigan P.A. of 1970, the corner points mentioned in lines 1 and 2 above were in conformance with regulations and rules therefore as required in the current manual of survey instructions of the United States Department of the Interior, Bureau of Land Management or by a decree of a Court of Law and/or that the corner points mentioned in lines 3, 4 and 5 above were in conformance with the rules of the Michigan Board of Land Surveyors or by a Decree of a Court of Law; established, re-established, monumented, recovered, found as expressed below:

NOTE: Not more than 2 corners, all in the same town and range, may be recorded on this certificate.

A. Description of original monument and accessories and/or subsequent restoration:

N1/4 Corner Section 6, T9S, R6E (not common)/ Yankee Road, 3 inch asphalt, 6 inch stone, 8 inch stone, clay, yellow sand.

Corner not set by GLO/ 1981 Glenn Richard notes found strap iron as N1/4 corner, source of corner unknown. 1994 Recovered corner and set 1 inch x 36 inch iron pipe at surface

B. Description of corner evidence found and/or method applied in restoring or reestablishing corner:

9/21/94, found a 3/4 inch iron pipe at surface, dug a 24 inch x 30 inch hole, found a flat bar 18 inches long x 2 inches, 14 inches deep. Found no stone or post, probed, hard in all directions, found nothing.

C. Description of monument for corner and accessories established to perpetuate locating the position of the corner:

Set 1 inch x 36 inch iron pipe with brass remonumentation cap inside monument box to replace found pipe and is accepted as the best available evidence of the position of the original corner.

Witnesses:

South 30° East 63.82 feet to + in NE face of fence corner post.

South 20° East 56.88 feet to + in NW face of fence corner post.


South 67.16 feet to nail/shiner in North face of power pole.

North 45° East 24.12 feet to + in south face of pipeline marker.

Signed by Bruce Antcliff

Surveyor's Michigan License No. 25826

Date 12-22-95

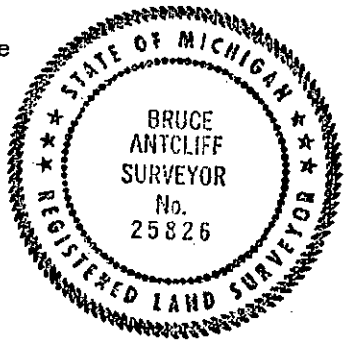

⑦ B-1, T9S, R6E,
WHITEFORD TWP.