

JAN 27 1994

LAND CORNER RECORDATION CERTIFICATE
Filing Requirement of Act 74, Mich. P.A. 1970

RECEIVED FOR RECORD
93 NOV 30 PM 1:52

For corners in

Monroe

(County)

Located In:
Bedford Twp.

Corner Code #
Michigan-Ohio
Line

1. Public Land Survey

T _____ R _____

T _____ R _____

T _____ R _____

T _____ R _____

2. Property Controlling
in Section

S _____ T _____ R _____

S _____ T _____ R _____

3. Miscellaneous
Property in Sec.

S 6 T 9S R 7E

S _____ T _____ R _____

Post 59

Peri Allen
REGISTER OF DEEDS
MONROE COUNTY, MI

Register of Deeds Stamp & File Number

4. Lot No. _____, Recorded Plat _____

5. Private Claims _____

1993 MONROE COUNTY REMONUMENTATION PROGRAM Peer Group
approved corner on 11/16/1993 per Act 345 of 1990.

G.B. Warnke, in a field survey on 11-08, 19 93

do hereby certify that under requirements of P.A. 74, Michigan P.A. of 1970, the corner points mentioned in lines 1 and 2 above were in conformance with regulations and rules therefore as required in the current manual of survey instructions of the United States Department of the Interior, Bureau of Land Management or by a decree of a Court of Law and/or that the corner points mentioned in lines 3, 4 and 5 above were in conformance with the rules of the Michigan Board of Land Surveyors or by a Decree of a Court of Law; established, re-established, monumented, re-monumented, recovered, found as expressed below:

NOTE: Not more than 4 corners, all in the same town and range, may be recorded on this certificate.

	A	B	C	D	E	F	G	H	I	J	K
2	1	2	3	4	5	6	7	8	9	10	11
3	12	13	14	15	16	17	18	19	20	21	22
4	23	24	25	26	27	28	29	30	31	32	33
5	34	35	36	37	38	39	40	41	42	43	44
6	45	46	47	48	49	50	51	52	53	54	55
7	56	57	58	59	60	61	62	63	64	65	66
8	67	68	69	70	71	72	73	74	75	76	77
9	78	79	80	81	82	83	84	85	86	87	88
10	89	90	91	92	93	94	95	96	97	98	99
11	100	101	102	103	104	105	106	107	108	109	110
12	111	112	113	114	115	116	117	118	119	120	121
13	122	123	124	125	126	127	128	129	130	131	132


A. Description of original monument and accessories and/or subsequent restoration:

Post 59 Michigan - Ohio Marker (West Side of Clover Lane)

June 31, 1837, G.L.O. Surveyor Ambrose Rice west on state line from east line of Section 6 at 40.20 chains passed 11 mile post. No reference to passing road at 1/8 line (Clover Lane). / 1915 Ohio - Michigan survey set granite post on west side of road (Clover Lane) c line with stone in centerline of said road, accepted as being on state line. / Surveyors have referenced Post 59 in their surveys.

B. Description of corner evidence found and/or method applied in restoring or reestablishing corner:

11/08/1993 - Found Post 59 of Michigan - Ohio Line - Stone Monument being 30 inches out of ground. Post could easily be damaged by traffic as construction in area has exposed 18 inches of the 48 inch base.

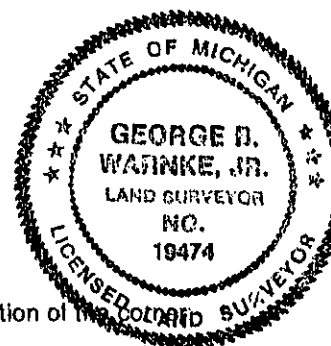

C. Description of monument for corner and accessories established to perpetuate locating the position of the corner:

Found Post 59 of Michigan - Ohio Line - Stone Monument being 30 inches out of ground & is accepted as the best available evidence of the position of the original corner & witnesses:

East 8.5' west edge of asphalt

East 19.12' railroad spike in approximate centerline of Clover Lane (possible 1/8 line)

West 6.06' east face of 1 1/2 inch (diameter) metal fence post (chain link fence to S & W)

South 40° East 62.00' set nail/shiner (4' above ground) in north face of light pole

South 50° East 56.18' top nut of hydrant

North 30° East 111.08' set nail/shiner (2 1/2' above ground) in south face of electric pole

South 75° East 89.10' northwest corner of siding of house No. 6158

Signed by

Date

11-30-93

Surveyor's Michigan License No.

19474

FORM APPROVED BY MICHIGAN STATE BOARD OF LAND SURVEYORS, JAN. 1
REVISED MAY 1
REVISED JAN

LINE

3

PAGE 303