

SURVEY & REMONUMENTATION

JAN 27 1994

LAND CORNER RECORDATION CERTIFICATE Filing Requirement of Act 74, Mich. P.A. 1970

RECEIVED FOR RECORD
93 NOV 30 PM 2:03

For Corners in

Monroe
(County)

Located In:
Bedford Twp.,

Corner Code #
Michigan-Ohio
Line

1. Public Land Survey

T _____ R _____
T _____ R _____
T _____ R _____
T _____ R _____

#2

2. Property Controlling
in Section

S _____ T _____ R _____
S _____ T _____ R _____

3. Miscellaneous
Property in Sec.

S 5 T 9S R 7E
S _____ T _____ R _____

Post 60

Register of Deeds Stamp & File Number

4. Lot No. _____, Recorded Plat _____

5. Private Claims _____

1993 MONROE COUNTY REMONUMENTATION PROGRAM Peer Group
approved corner on 11/08/1993 per Act 345 of 1990.

I, G.B. Warnke, in a field survey on 11-08, 19 93

do hereby certify that under requirements of P.A. 74, Michigan P.A. of 1970, the corner points mentioned in lines 1 and 2 above were in conformance with regulations and rules therefore as required in the current manual of survey instructions of the United States Department of the Interior, Bureau of Land Management or by a decree of a Court of Law and/or that the corner points mentioned in lines 3, 4 and 5 above were in conformance with the rules of the Michigan Board of Land Surveyors or by a Decree of a Court of Law; established, re-established, monumented, re-monumented, recovered, found as expressed below:

NOTE: Not more than 4 corners, all in the same town and range, may be recorded on this certificate.


A. Description of original monument and accessories and/or subsequent restoration:

Post 60 Michigan - Ohio Marker (East Side of Secor Road)
June 3, 1837, G.L.O. Surveyor Ambrose Rice went north between Sections 5 & 6, T9S, R7E, 40.80 chains past post in State Line. / 1915, Ohio - Michigan boundary survey set granite post No. 60 on the east side of Secor Road. / October 17, 1992, Volunteer Surveyors of Michigan - Ohio Line Resurvey found Post 60 intact. / Approximately January 13, 1992, Post 60 was hit by car & broken. Monroe County Surveyor, G.B. Warnke investigated the incident & discovered that the top 18 inch portion (broken off) was removed from the scene. After an article appeared in The Toledo Blade newspaper on April 22, 1993 about incidents relating to the state line, the top of Post 60 was recovered and later re-attached with epoxy cement.

B. Description of corner evidence found and/or method applied in restoring or reestablishing corner:

Found Post 60 of Michigan - Ohio Line & witnessed as shown below.

	A	B	C	D	E	F	G	H	I	J	K	L
2	6	5	4	3	2							
3												
4	7	8	9	10	11							
5												
6	16	17	18	15	14							
7												
8	19	20	21	22	23							
9												
10	30	29	28	27	26							
11												
12	31	32	33	34	35							
13												

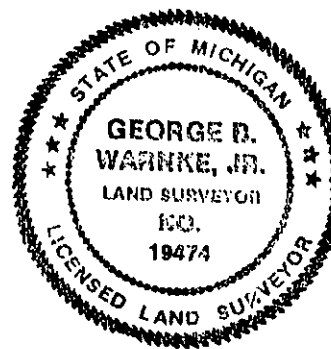

C. Description of monument for corner and accessories established to perpetuate locating the position of the corner:

Post 60 of Michigan - Ohio Line & is accepted as a careful and faithful perpetuation of the position of the original corner & witnesses:
South 65° West 63.90' set nail/shiner in north face of utility pole
West 21.2' east edge of pavement
West 3.28' "L" in Lucas County on brass bench mark plate on concrete marker
South 30° West 8.43' top nut of hydrant
South 10° West 52.40' found nail/aluminum shiner in west face of pole
North 40° East 68.28' northwest corner of foundation of house No. 6144 Secor Road
North 05° West 61.46' set nail/shiner in west face of electric pole

Signed by

Date

11-30-93

Surveyor's Michigan License No. 19474

FORM APPROVED BY MICHIGAN STATE BOARD OF LAND SURVEYORS, JAN. 28
REVISED MAY 14
REVISED JAN.