

JAN 27 1994

LAND CORNER RECORDATION CERTIFICATE
Filing Requirement of Act 74, Mich. P.A. 1970

RECEIVED FOR RECORD
93 NOV 30 PM 2:04

COMMISSION
For corners in

Monroe

(County)

Located in:
Bedford Twp.

Corner Code #
Michigan-Ohio
Line

1. Public Land Survey

T _____ R _____

T _____ R _____

T _____ R _____

T _____ R _____

2. Property Controlling
In Section

S _____ T _____ R _____

S _____ T _____ R _____

3. Miscellaneous
Property In Sec.

S 4 T 2S R 7E

S _____ T _____ R _____

#3

Post 61

Fori Allen
REGISTER OF DEEDS
MONROE COUNTY, MICH

Register of Deeds Stamp & File Number

4. Lot No. _____, Recorded Plat _____

5. Private Claims _____

MONROE COUNTY REMONUMENTATION PROGRAM Peer Group
approved corner on 11/08/1993 per Act 345 of 1990.

I, G.B. Warnke, in a field survey on 11-8, 1993

do hereby certify that under requirements of P.A. 74, Michigan P.A. of 1970, the corner points mentioned in lines 1 and 2 above were in conformance with regulations and rules therefore as required in the current manual of survey instructions of the United States Department of the Interior, Bureau of Land Management or by a decree of a Court of Law and/or that the corner points mentioned in lines 3, 4 and 5 above were in conformance with the rules of the Michigan Board of Land Surveyors or by a Decree of a Court of Law; established, re-established, monumented, re-monumented, recovered, found as expressed below:

NOTE: Not more than 4 corners, all in the same town and range, may be recorded on this certificate.

A. Description of original monument and accessories and/or subsequent restoration:

Post 61 Michigan - Ohio Marker (East side of Douglas Road)

June of 1837, G.L.O. Surveyor Ambrose Rice went north between Sections 4 & 5, T9S, R7E, 42.62 chains pass post in State Line. / 1915 Ohio - Michigan boundary survey set granite Post No. 61 on east side of Douglas Road. / Volunteer Surveyors on re-survey of Michigan - Ohio Line found top 18 inches of post broken off but didn't recover top. Neighbors in are were not aware its existance any more. / October 18, 1992, Dean Ringle set aluminum disc a top center of remains of post. / January 16, 1993, Post 61 was observed by G.P.S. / Post recorded earlier in L.C.R.C., Liber 3, Page 267. / Post & disc were witnessed on 11-8-93.

B. Description of corner evidence found and/or method applied in restoring or reestablishing corner:

Post 61 with disc for Michigan - Ohio Line and witnessed as shown below.

C. Description of monument for corner and accessories established to perpetuate locating the position of the corner:

Post 61 with disc for Michigan - Ohio Line & is accepted as a careful and faithful perpetuation of the position of the original corner & witnesses:

West 24.83' railroad spike found at centerline of Douglas Road

South 80° West 43.93' top nut of hydrant (Toledo)


North 05° East 99.18' top nut of hydrant (Bedford Township)

South 65° East 12.13' nail/shiner in northwest face of electric pole

Signed by

G.B. Warnke

Surveyor's Michigan License No. 19474

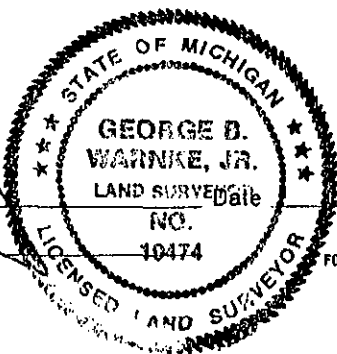

11/30/93

FORM APPROVED BY MICHIGAN STATE BOARD OF LAND SURVEYORS, JAN. REVISED MAY REVISED JJ