

DEC 19 2000

MONTCALM COUNTY REMONUMENTATION PROGRAM

LAND CORNER RECORDATION CERTIFICATE

Filing Requirement of Act 74, Mich. P.A. 1970

SECTION

For corners in

Montcalm

(County)

Located In:

Bushnell Township

Corner Code #

1. Public Land Survey Sec. 5,6,7,8T 09 N R 06 W

C-03

2. Property Controlling
in Section

S

T

R

3. Miscellaneous
Property in Sec.

S

T

R

4. Lot No. _____, Recorded Plat _____

5. Private Claims _____

I, William G. Tingley, in a field survey on April 19, 2000, do hereby certify that under requirements of P.A. 74, Michigan P.A. of 1970, the corner points mentioned in lines 1 and 2 above were in conformance with regulations and rules therefore as required in the current manual of survey instructions of the United States Department of the Interior, Bureau of Land Management or by a decree of a Court of Law and/or that the corner points mentioned in lines 3, 4 and 5 above were in conformance with the rules of the Michigan Board of Land Surveyors or by a Decree of a Court of Law; established, re-established, monumented, re-monumented, recovered, found as expressed below:

NOTE: Not more than 2 corners, all in the same town and range, may be recorded on this certificate.

A. Description of original monument and accessories and/or subsequent restoration:

1. November 13, 1837, Noah Brookfield, Deputy Surveyor, GLO notes, North between Sections 7 and 8. Set post corner of Sections 5, 6, 7 and 8

W. oak 18" N72°E 11 links (7.26 feet)
W. oak 20" S76°W 9 links (5.94 feet)

2. No date, George Stevenson corner witness file T09N-R-06W at Tingley and Associates office SE corner Section 6. Found stone with chiseled (X). Drove ½" x 30" iron and bent over (X) mark.

Tele. Con. Box East 17.00 feet
Power pole N30°W 109.00 feet
Rd. sign post S45°W 40.50 feet

3. October 09, 1972, Patrick A. Salisbury # 13594, Certificate of Survey Liber 467 Page 992

Found stone with ½" rod

Oak 24" NNW 141.55 feet
Tel. Cable marker East 17.10 feet

4. February 2, 1989, William G. Tingley # 30104, LCRC Liber 002 Page 242

Found ½" iron

Riser box East 16.90 feet
Street sign S45°W 46.20 feet
Gray rock N45°W 41.60 feet
South post road sign East 13.40 feet

5. February 2, 1989, William G. Tingley # 30104, Certificate of Survey Liber 631 Page 423

Found ½" iron rod

Riser box East 16.90 feet
Street sign S45°W 46.20 feet
Gray rock N45°W 41.60 feet
South post road sign East 13.40 feet

6. December 23, 1992, William G. Tingley # 30104, LCRC Liber 003 Page 043

Found ½" iron rod

Riser box East 16.90 feet
Street sign S45°W 46.20 feet
Gray rock N45°W 41.60 feet
South post road sign East 13.40 feet

7. December 28, 1992, William G. Tingley # 30104, Land Title Survey # 92634

Found ½" rebar

No witnesses given

B. Description of corner evidence found and/or method applied in restoring or reestablishing corner:

Searched the apparent location of the corner. Excavated 4.00 feet x 5.00 feet x 3.00 feet deep. Found ½" x 24" bent rerod at surface of road. Found stone 0.60 foot by 1.70 foot with a "X" marked on the side. Found no other evidence.

C. Description of monument for corner and accessories established to perpetuate locating the position of the corner:

Set remonumentation pipe in place of ½" rerod and stone. Set stone on south side of pipe

T/C phone riser N89°E 32.82 feet
South leg "Arrow" sign S76°E 14.20 feet
Set N/T NE/S power pole N24°W 110.86 feet
South leg "Stop" sign S66°W 45.62 feet



LIBER 4

PAGE 243

This corner is accepted as the best available of the position of the original corner.

Bearings given are magnetic. Standard remonumentation pipe consists of a Berntsen stainless steel 2 3/8" x 30" pipe with a brass cap stamped "MONTCALM COUNTY REMONUMENTATION, P.S. # 30104"

Signed by

William Tingley


Date

6/14/00

Surveyor's Michigan License No.

30104

FORM APPROVED BY MICHIGAN STATE BOARD OF LAND SURVEYORS, JAN. 28, 1971
REVISED MAY 14, 1978
REVISED JAN., 1983
ADAPTED FOR WORD PROCESSING MARCH, 1993

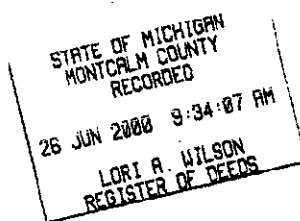

Register of Deeds Stamp & File Number

	A	B	C	D	E	F	G	H	I	J	K	L	M
2	6	5	4	3	2	1							
3													
4	7	8	9	10	11	12							
5													
6	18	17	16	15	14	13							
7													
8	19	20	21	22	23	24							
9													
10	30	29	28	27	26	25							
11													
12	31	32	33	34	35	36							
13													

ACCEPTED BY THE MONTCALM COUNTY SURVEY REEF.
GROUP AS THE OFFICIAL CORNER UNDER MICHIGAN
PUBLIC ACT 345 OF 1990 AT A MEETING HELD 6/14/00

WGT
William Tingley, PS, Chairman

