

**LAND CORNER RECORDATION CERTIFICATE**  
**Filing Requirement of Act 74, Mich. P.A. 1970**

For corners in

Montclair

(County)

Located In:

Corner Code //

1. Public Land Survey

T R

T R

T R

T R

2. Property Controlling  
in Section

S 31 T 20 R 7W 10

S 32 T 20 R 7W 15

3. Miscellaneous

S T R

Property in Sec.

S T R

4. Lot No , Recorded Plat

5. Private Claims

**Register of Deeds Stamp & File Number**

I, Gary C. Bilow, in a field survey on 10 February 19, 1993, do hereby certify that under requirements of P.A. 74, Michigan P.A. of 1970, the corner points mentioned in lines 1 and 2 above were in conformance with regulations and rules therefore as required in the current manual of survey instructions of the United States Department of the Interior, Bureau of Land Management or by a decree of a Court of Law and/or that the corner points mentioned in lines 3, 4 and 5 above were in conformance with the rules of the Michigan Board of Land Surveyors or by a Decree of a Court of Law, established, re-established, monumented, re-monumented, recovered, found as expressed below

**NOTE: Not more than 4 corners, all in the same town and range, may be recorded on this certificate.**

**A. Description of original monument and accessories and/or subsequent restoration:**

10: Not set in 1837 GLO survey by Noah Brookfield. County Surveyor Daoust set a flat iron with crossbar for the corner in a 1906 survey and witnessed an Oak 18, S 58-1 2 E, 51 links. Daoust set the corner MPOL between the C12 and C13.

15: Not established in 1937 GLO survey by Noah Brookfield. County Surveyor Daoust reports setting an iron clewchee and stone for this corner in 1906 and witnesses an Oak 3, N34W, 50 links.

**B. Description of corner evidence found and/or method applied in restoring or reestablishing corner:**


10: Found flat iron and crossbar and 1906 bearing tree, now 30" diameter and dead. Flat iron is 0.60 west of line between C12 and C13 and 0.9 south of split. Accepted flat iron as corner.

15: Daoust's monument and B1 were not found. Established corner mid-way and on line between C13 and D13.

**C. Description of monument for corner and accessories established to perpetuate locating the position of the corner:**

10: Replaced flat iron with 1/2" x 36" rebar encased in a 4" diameter concrete cylinder capped with a cast aluminum Michigan Department of Natural Resources tablet  
 S55R. 35.51. PR&tag in 30" dead Oak-ORT  
 S19E. 67.90. PR&tag in 33" Oak  
 S35W. 48.96. PR&tag in 11" Walnut  
 S79W. 9.04. PR&tag in 8" Oak  
 West. 3. west edge Miller Road  
 Flat iron placed along side

15: Set 1/2" x 36" rebar encased in a 4" diameter concrete cylinder and capped with a cast aluminum Michigan Department of Natural Resources tablet  
 N58R. 48.78. spike & tag in 8" W Pine  
 S32E. 10.98. spike & tag in 8" W Oak  
 N64W. 8.16. spike & tag in 12" W Oak  
 N80R. 21.50. 2" pipe

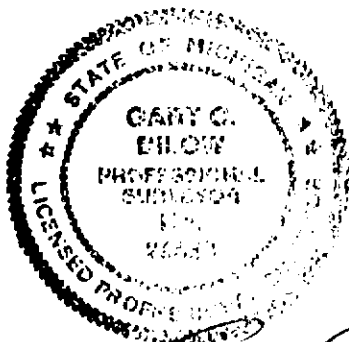

Signed by

Surveyor's Michigan License No.

Date

FORM APPROVED BY MICHIGAN STATE BOARD OF LAND SURVEYORS, JAN. 28, 1971  
 REVISED MAY 14, 1975  
 REVISED JAN. 1983

AGE PAGE 34