

SURVEY &
REMONUMENTATION

FEB 19 1998

MONTCALM COUNTY REMONUMENTATION
LAND CORNER RECORDATION CERTIFICATE
Filing Requirement of Act 74, Mich. P.A. 1970

SECTION

For corners in
Montcalm
(County)

Located In:

Corner Code #

1. Public Land Survey	Sec 1	T 10 N R 8 W	K-1, NW Corner
		T R	
		T R	
		T R	
		T R	
2. Property Controlling in Section	S	T R	
	S	T R	
3. Miscellaneous Property in Sec.	S	T R	
	S	T R	

4. Lot No. _____, Recorded Plat _____
5. Private Claims _____

I, William Tingley a field surveyor on _____, 1997,
do hereby certify that under requirements of P.A. 74, Michigan P.A. of 1970, the corner points mentioned
in lines 1 and 2 above were in conformance with regulations and rules therefore as required in the
current manual of survey instructions of the United States Department of the Interior, Bureau of Land
Management or by a decree of a Court of Law and/or that the corner points mentioned in lines 3, 4 and 5
above were in conformance with the rules of the Michigan Board of Land Surveyors or by a Decree of a
Court of Law; established, re-established, monumented, re-monumented, recovered, found as
expressed below:

NOTE: Not more than 4 corners, all in the same town and range, may be recorded
on this certificate.

A. Description of original monument and accessories and/or subsequent restoration:

March 23, 1838, Noah Brookfield, Deputy Surveyor, GLO Notes

Set Post of E-2

Pine 50" Is Corner

June 1875, from R.D. McNutt's Index Cards 10-8 (11)

Pine Stump 40" S10°W 54 links

January 1888, F.A. Palmer, County Surveyor, Book 1, page 197, Record of Minutes of Survey

Found Pine Stump all right

1888, H.M. Caukin, county Surveyor, Liber 1, page 439, Record of Minutes of Survey

No description of monument. Corner 3135 feet East of Corner 35-36 T11N, R8W

1898, H.M. Caukin, County Surveyor, Liber 2, Page 64, Record of Minutes of Survey

N89°50'E true line from Northwest Corner Section 1 (K-1). 32.04 to Southeast Corner of Township T11N-R8W

1977, G.M. Stevenson, Jr. #13600

Set South 1/4 Section 36, T11N-R8W 511.41 feet West of Corner Section 2 (not monumented)

June 1992, W.G. Tingley, #30104

Set Capped Iron 2120.47 feet West of the Southeast corner and 510.85 feet East of the South 1/4 of section 36, T11N-R8W.

Set Nail and Tag South side 18" Oak N65°W 109.75 feet

Set Nail and Tag East side 16" Oak North 38.39 feet

Set Nail and Tag West side 12" Poplar N45°E 55.58 feet

Set Nail and Tag West side Power Pole S25°E 179.32 feet

B. Description of corner evidence found and/or method applied in restoring or reestablishing corner:

Found 1/2" Iron rod with orange cap (illegible).

Found Nail and Tag #30104 East side 14" Oak North 39.90 feet

Found Nail and Tag #30104 South side 18" Oak N50°W 109.98 feet

Found Nail and Tag #30104 Northwest side 14" Poplar N45°E 55.55 feet

Found Nail and Tag #30104 Northeast side Power Pole S15°E 179.18 feet

C. Description of monument for corner and accessories established to perpetuate locating the position of the corner:

Set standard Remonumentation corner over 1/2" iron rod.

Found Nail and Tag #30104 East side 14" Oak North 39.90 feet

Found Nail and Tag #30104 South side 18" Oak N50°W 109.98 feet

Found Nail and Tag #30104 Northwest side 14" Poplar N45°E 55.55 feet

Found Nail and Tag #30104 Northeast side Power Pole S15°E 179.18 feet

This corner is accepted as the best available evidence of the position of the original corner.

Signed by William G. Tingley Date 7/30, 1997

Surveyor's Michigan License No. 30104

FORM APPROVED BY MICHIGAN STATE BOARD OF LAND SURVEYORS, JAN. 28, 1971
REVISED MAY 14, 1975
REVISED JAN., 1983
ADAPTED FOR WORD PROCESSING MARCH, 1983

STATE OF MICHIGAN
MONTCALM COUNTY
RECORDED

26 Dec 1997 3:36:45 PM


LORI A. WILSON
REGISTER OF DEEDS

Register of Deeds Stamp & File Number

	A	B	C	D	E	F	G	H	I	J	K	L	M
1													
2	6	5	4	3	2	1							
3													
4	7	8	9	10	11	12							
5													
6	18	17	16	15	14	13							
7													
8	19	20	21	22	23	24							
9													
10	30	29	28	27	26	25							
11													
12	31	32	33	34	35	36							
13													

ACCEPTED BY THE MONTCALM COUNTY SURVEY PEE
GROUP AS THE OFFICIAL CORNER UNDER MICHIGAN
PUBLIC ACT 345 OF 1990 AT A MEETING HELD 7/30/97

WGT
William Tingley, PS, Chairman

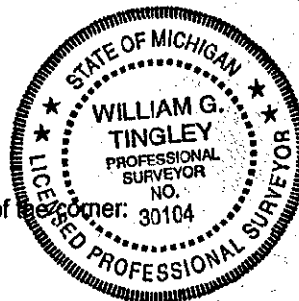

LIBER 3 PAGE 370