

## MONTCALM COUNTY REMONUMENTATION PROGRAM

DEC 19 2000

## LAND CORNER RECORDATION CERTIFICATE

Filing Requirement of Act 74, Mich. P.A. 1970

SECTION

For corners in

Montcalm

(County)

Located In:

Corner Code #

Township

1. Public Land Survey Sec. 32 T 11 N R 10 W

D-13

2. Property Controlling S T R

3. Miscellaneous S T R

Property in Sec. S T R

4. Lot No. , Recorded Plat

5. Private Claims

I, William G. Tingley, in a field survey on May 10, 2000

do hereby certify that under requirements of P.A. 74, Michigan P.A. of 1970, the corner points mentioned in lines 1 and 2 above were in conformance with regulations and rules therefore as required in the current manual of survey instructions of the United States Department of the Interior, Bureau of Land Management or by a decree of a Court of Law and/or that the corner points mentioned in lines 3, 4 and 5 above were in conformance with the rules of the Michigan Board of Land Surveyors or by a Decree of a Court of Law, established, re-established, monumented, re-monumented, recovered, found as expressed below:

**NOTE: Not more than 2 corners, all in the same town and range, may be recorded on this certificate.**

A. Description of original monument and accessories and/or subsequent restoration:

1. December 12, 1936, Noah Brookfield, Deputy Surveyor, GLO notes, West on south side of section 32

Leave lake and set quarter section post at 40.00 chains

Pine 10" N75°E 12 links (7.92 feet)

Do 9" N23°W 11 links (7.26 feet)

2. April 15, 1905, John F. Daoust, County Surveyor, Record of Minutes of Survey section 32 T11N R10W

Found stone, crockery, and stump of Bearing Tree agreeing

Pine stump 9" N75°E 12 links (7.92 feet)

3. January 4, 1956, Anderson's Sand Lake Lots Plat Liber 007 Page 030

Meander and S¼ corner Section 32 T11N-R10W

No description or witnesses given

4. August 3, 1966, Harlan J. Page, Survey chief, Michigan State Highway Department, Gov't. Monument Witness Record

Corner missing, was reestablished from exist. monuments of adjacent property survey of 1956 by Mr. Lee C. Darling, RLS of Tarrant MI. Placed ¾"

iron pipe 36" long

Willow 4" N05°E 16.68 feet

Oak 35" West 46.19 feet

5. July 25, 1989, Glen S. Hackbardt, # 25844, Certificate of Survey Liber 640 Page 370

Found ¾" iron

Willow 36" North 16.16 feet

Oak 30" West 45.10 feet

Elm 10" S10°W 18.80 feet

Waters Edge East 3.30 feet

6. July 25, 1989, Glen S. Hackbardt, # 25844, LCRC Liber 002 Page 285

Found ¾" pipe which checked both of the above witts. Also traversed into record plat (Anderson's Sand Lake Lots) this pipe checks to within 1.00 feet of the position shown on that plat

Willow 36" North 16.16 feet

Oak 30" West 45.10 feet

Elm 10" S10°W 18.80 feet

Waters Edge East 3.30 feet

7. June 05, 2000, Kirk Breittels #30077, Kent Co. Remonumentation LCRC # 11838

Compute C-01 on a projection of a line North from the E¼ corner of Sec. 6 through the concrete nail to the township line created by D-13 (Montcalm County Mon.) and E-13 (Montcalm County Mon.) Pierson Twp. Montcalm County

B. Description of corner evidence found and/or method applied in restoring or reestablishing corner:

Searched the apparent location of the corner. Found ¾" iron pipe 1" above ground on west side of Sand Lake.

C. Description of monument for corner and accessories established to perpetuate locating the position of the corner.

Set remonumentation pipe. Set carsonite marker on east side of remon pipe.

Fnd Nail in 16" Elm S30°W 18.80 feet

Fnd burnt stump North 16.90 feet

N/T N/S 12" Elm N44°W 27.33 feet

N/T N/S 5" Choke Cherry N80°W 37.21 feet

N/T NW/S 14" Oak S61°W 41.40 feet

Waters edge East 3.30 feet


This corner is accepted as best available evidence of the position of the original corner.

Bearings given are magnetic. Standard remonumentation pipe consists of a Berntsen stainless steel 2 3/8" x 36" pipe with a brass cap stamped "MONTCALM COUNTY REMONUMENTATION, P.S. # 30104"

Signed by William G. Tingley Date 8/09/00


Surveyor's Michigan License No. 30104

FORM APPROVED BY MICHIGAN STATE BOARD OF LAND SURVEYORS, JAN. 28, 1971  
REVISED MAY 14, 1975  
REVISED JAN. 1983  
ADAPTED FOR WORD PROCESSING MARCH, 1993

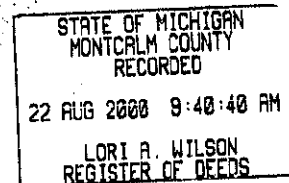

Register of Deeds Stamp &amp; File Number

	A	B	C	D	E	F	G	H	I	J	K	L	M
1													
2	6	5	4	3	2	1							
3													
4	7	8	9	10	11	12							
5													
6	18	17	16	15	14	13							
7													
8	19	20	21	22	23	24							
9													
10	30	29	28	27	26	25							
11													
12	31	32	33	34	35	36							
13													

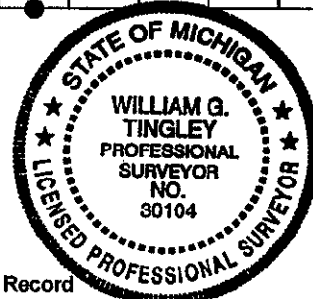

ACCEPTED BY THE MONTCALM COUNTY SURVEY PEER GROUP AS THE OFFICIAL CORNER UNDER MICHIGAN PUBLIC ACT 345 OF 1990 AT A MEETING HELD 8/09/00

William Tingley, PS, Chairman

LIBER 4 PAGE 259

