

SURVEY &
REMONUMENTATION

AUG 3 1 1994

COMMISSIONER

MONTCALM COUNTY REMONUMENTATION PROGRAM

Corner approved by Peer Group on _____, 1994

LAND CORNER RECORDATION CERTIFICATE

Filing Requirement of Act 74, Mich. P.A. 1970

For corners in

Montcalm
(County)

Located in:

Corner Code #

1. Public Land Survey Sec 31 T 12 R 10 A-12, W 1/4
T R
T R
T R
T R
2. Property Controlling S T R
in Section S T R
3. Miscellaneous S T R
Property in Sec. S T R

4. Lot No. _____, Recorded Plat _____
5. Private Claims _____

I, William Tingley a field survey on July 29, 1994
do hereby certify that under requirements of P.A. 74, Michigan P.A. of 1970, the corner points mentioned
in lines 1 and 2 above were in conformance with regulations and rules therefore as required in the
current manual of survey instructions of the United States Department of the Interior, Bureau of Land
Management or by a decree of a Court of Law and/or that the corner points mentioned in lines 3, 4 and 5
above were in conformance with the rules of the Michigan Board of Land Surveyors or by a Decree of a
Court of Law; established, re-established, monumented, re-monumented, recovered, found as
expressed below:

NOTE: Not more than 4 corners, all in the same town and range, may be recorded
on this certificate.

A. Description of original monument and accessories and/or subsequent restoration:

June 1837, John Hodgson, Deputy Surveyor, GLO Notes

Set Post.

White Oak 10" S43°W 40 links

White Oak 10" N57°W 41 links

Field Notes, 12-10 Page 46, County Surveyor Field Book. no date given

Oak 10" N61°30'W 70-1/2 links

Maple 8" N39°45'E 57-1/2 links

R.D. McNutt's Index Cards, 12-10 (114)

Same as above

B. Description of corner evidence found and/or method applied in restoring or reestablishing corner:

Found 1-1/4" Iron Pipe, 13" Long drove on 1/2" square rod

3 foot deep found 1-1/4" Gas Pipe set in Nest of Stones

Found Nail in 30" Oak N55°W 46.35 feet

Found Nail in Guy Pole S45°E 39.39 feet

ACCEPTED BY THE MONTCALM COUNTY SURVEY PEER
GROUP AS THE OFFICIAL CORNER UNDER MICHIGAN
PUBLIC ACT 345 OF 1990 AT A MEETING HELD 22 July 94

William Tingley
William Tingley, PS, Chairman

C. Description of monument for corner and accessories established to perpetuate locating the position of the corner:

Set Remonumentation Corner and Monument Box. over pipes and nest of stones

Found Nail in 30" Oak N55°W 46.35 feet

Found Nail in Guy Pole S45°E 39.39 feet


Set Nail in Eastside 30" Oak N25°W 89.27 feet

Stop/Street Sign S60°W 48.35 feet

This corner is accepted as a careful and faithful perpetuation of the position of the original corner.

Signed by William Tingley Date 22 July, 1994

Surveyor's Michigan License No. 30104

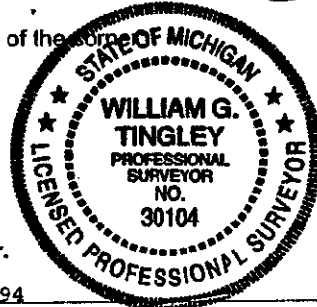

FORM APPROVED BY MICHIGAN STATE BOARD OF LAND SURVEYORS, JAN. 28, 1971

REVISED MAY 14, 1975

REVISED JAN., 1983

ADAPTED FOR WORD PROCESSING MARCH, 1993

	A	B	C	D	E	F	G	H	I	J	K	L	M
1													
2	6	5	4	3	2	1							
3													
4	7	8	9	10	11	12							
5													
6	18	17	16	15	14	13							
7													
8	19	20	21	22	23	24							
9													
10	30	29	28	27	26	25							
11													
12	31	32	33	34	35	36							
13													

LIBER 3 PAGE 106