

STATE OF MICHIGAN
RECORDS & DEEDS

1993

LIB 1744 CASE 545

STATE OF MICHIGAN
COUNTY OF MUSKEGON
RECORDS & DEEDS

1993 DEC 29 PM 4:02

COMMISSION

LAND CORNER RECORDATION CERTIFICATE
Filing Requirement of Act 74, Mich. P.A. 1970

Carrie Carter
REGISTER OF DEEDS

For corners in
MUSKEGON

(County)

Located In:

Corner Code #:

1. Public Land Survey T 9N R 15W H-4
T R
T R
T R
2. Property Controlling S T R
in Section S T R
3. Miscellaneous S T R
Property in Sec. S T R

4. Lot No. , Recorded Plat
5. Private Claims

Register of Deeds Stamp & File Number

STEPHEN V. VALLIER, in a field survey on NOVEMBER 24, 19 93
do hereby certify that under requirements of P.A. 74, Michigan P.A. of 1970, the corner points mentioned
in lines 1 and 2 above were in conformance with regulations and rules therefore as required in the
current manual of survey instructions of the United States Department of the Interior, Bureau of Land
Management or by a decree of a Court of Law and/or that the corner points mentioned in lines 3, 4 and 5
above were in conformance with the rules of the Michigan Board of Land Surveyors or by a Decree of a
Court of Law; established, re-established, monumented, re-monumented, recovered, found as
expressed below:

NOTE: Not more than 4 corners, all in the same town and range, may be recorded
on this certificate.

	A	B	C	D	E	F	G	H	I	J	K	L	M
2	6	5	4	3	2	1							
3													
4	7	8	9	10	11	12							
5													
6	18	17	16	15	14	13							
7													
8	19	20	21	22	23	24							
9													
10	30	29	28	27	26	25							
11													
12	31	32	33	34	35	36							
13													


A. Description of original monument and accessories and/or subsequent restoration:
CORNER NOT SET BY GLO

IRON-GTW R/R RIGHT-OF-WAY MAPS 1920
NO WITNESSES BUT CORNER IS REPRESENTED
AT CENTERLINE OF R/R
FOUND 1/2" IRON ROD-WESTSHORE ENG. &
SURVEY-1986
S N 40°E N 70°W
54.88' 6.56' 39.30'
CENTER- 8" POP. 12" POP.
LINE R/R

B. Description of corner evidence found and/or method applied in restoring or reestablishing corner:
FOUND 1/2" IRON ROD AT COMPUTED INTERSECTION OF N-S AND E-W 1/4 LINES. EVIDENCE INDICATES POSITION
OF CENTER OF SECTION; MAY HAVE BEEN 54.88' SOUTH AT CENTERLINE OF E-W R/R LINE; NO EVIDENCE
OF THIS POSITION BEING MONUMENTED OR CAN BE RETRACED TO SOURCE OF ORIGIN.
HISTORICAL USAGE, DOCUMENTATION & EVIDENCE OF CORNER LOCATION REVIEWED AND RATIFIED BY
MUSKEGON COUNTY PEER GROUP, AUG. 3, 1993. (ACCEPTED FOUND 1/2" IRON ROD AT INTERSECTION OF
1/4 LINES)

C. Description of monument for corner and accessories established to perpetuate locating the position of the corner:
SET 4" X 30" CAST IRON MONUMENT WITH COUNTY SURVEY CAP (REPLACED 1/2" X 18" IRON ROD)
S 73°E N 8°E N 25°W N 84°W N 53°E S 24°E
64.98' 79.87' 66.71' 36.23 111.21' 137.40'
10" OAK 16" TW. ELM 4" POP. 4" POP. 4" OAK NW LEG OF
(FD. NAIL (FD. NAIL (FD. NAIL (FD. NAIL (SET NAIL STEEL TRANS.
N'LY SIDE) W'LY STDE) E'LY SIDE) N'LY SIDE) W'LY SIDE) TOWER

Signed by
STEPHEN V. VALLIER
Surveyor's Michigan License No. 28428

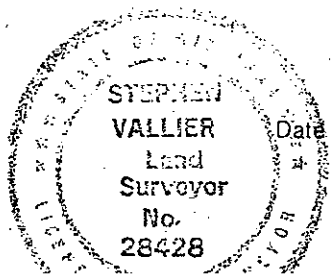

Dec 28, 1993