

LAND CORNER RECORDATION CERTIFICATE
Filing Requirement of Act 74, Mich. P.A. 1970

For corners in

<u>Marquette</u> (County)	Located In:	Corner Code <u>H-1</u>
1. Public Land Survey	T <u>43N</u> R <u>25W</u>	
	T _____ R _____	
	T _____ R _____	
	T _____ R _____	
2. Property Controlling in Section	S <u>3</u> T <u>43N</u> R <u>25W</u>	<u>1,2,1-mc</u>
	S _____ T _____ R _____	
3. Miscellaneous Property in Sec.	S _____ T _____ R _____	

Register of Deeds Stamp & File Number

4. Lot No. _____, Recorded Plat _____
5. Private Claims _____

	A	B	C	D	E	F	G	H	I	J	K	L	M
2	6	5	4	3	2	1							
3													
4	7	8	9	10	11	12							
5													
6	18	17	16	15	14	13							
7													
8	19	20	21	22	23	24							
9													
10	30	29	28	27	26	25							
11													
12	31	32	33	34	35	36							
13													

I, Paul R. Bressette, in a field survey on February 3 & 4, 19 92, do hereby certify that under requirements of P.A. 74, Michigan P.A. of 1970, the corner points mentioned in lines 1 and 2 above were in conformance with regulations and rules therefore as required in the current manual of survey instructions of the United States Department of the Interior, Bureau of Land Management or by a decree of a Court of Law and/or that the corner points mentioned in lines 3, 4 and 5 above were in conformance with the rules of the Michigan Board of Land Surveyors or by a Decree of a Court of Law; established, re-established, monumented, re-monumented, recovered, found as expressed below:


NOTE: Not more than 4 corners, all in the same town and range, may be recorded on this certificate.

A. Description of original monument and accessories and/or subsequent restoration:

- H-1. Quarter corner common to Sections 3 and 34. Wood post Sugar 8 N 43° E 19 lks, Fir 12 N 20° W 22 lks.
1. West One-sixteenth corner common to Sections 3 and 34. Not set in original survey, no evidence of subsequent establishment.
2. East One-sixteenth corner common to Sections 3 and 34. Not set in original survey, no evidence of subsequent establishment.
- mc. Meander corner on the left bank of the Escanaba River. Cedar 6 for meander corner Hemlock 15 S 38° W 35 lks.

B. Description of corner evidence found and/or method applied in restoring or reestablishing corner:

- H-1. No evidence of wood post or OBT's found. Corner re-established mid-point and on-line between the Northeast and Northwest corners of Section 3.
1. Corner established mid-point and on-line between the Northwest and North Quarter corners of Section 3.
2. Corner established mid-point and on-line between the Northeast and North Quarter corners of Section 3.
- mc. No evidence of corner tree or OBT found. Corner established on line between the Northeast and Northwest corners of Section 3 on the left bank of the river. Corner is 20 feet east of the proportionate distance.

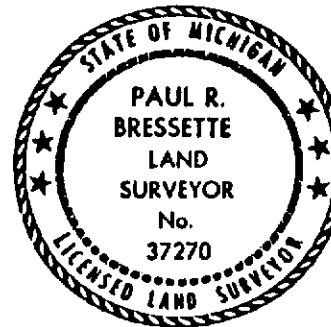

C. Description of monument for corner and accessories established to perpetuate locating the position of the corner:

- H-1. 1" pipe w/ 4" alum. cap. 9" Sugar (1/4S,NBT) N32°E 38.9'; 10" Sugar (1/4S,NBT) S70°E 18.7'; 5" Sugar (1/4S,NBT) S31°W 32.65'; 9" Sugar (1/4S,NBT) N78°W 11.1'.
1. 1" pipe w/ 4" alum. cap. 4" Cedar (1/16S,BT) N34°E 16.1'; 6" R. Maple (1/16S,BT) S53°E 35.2'; 6" Cedar (1/16S,BT) S10°W 7.55'; 5" Cedar (1/16S,BT) N69°W 29.55'.
2. 1" pipe w/ 4" alum. cap 5" Cedar (1/16S,BT) N10°E 6.5'; 6" Cedar (1/16S,BT) S64°E 7.1'; 7" Cedar (1/16S,BT) S45°W 10.2'; 8" Cedar (1/16S,BT) N43°W 7.65'.
- mc. 1" pipe w/ 4" alum. cap. 10" Spruce (MC,BT) N75°E 12.8'; 6" Spruce (MC,BT) S66°E 13.25'; 10" Cedar (MC,BT) S08°W 9.35'; 9" Cedar (MC,BT) N82°W 6.3'.

Signed by Paul R. Bressette Date 7-28-92
Surveyor's Michigan License No. 37270