

LAND CORNER RECORDATION CERTIFICATE  
Filing Requirement of Act 74, Mich. P.A. 1970

For corners in

<u>Marquette</u> (County)	Located In:	Corner Code <u>H-11</u>
1. Public Land Survey	T <u>45N</u> R <u>23W</u>	
	T _____ R _____	
	T _____ R _____	
	T _____ R _____	
2. Property Controlling in Section	S _____ T _____ R _____	
	S _____ T _____ R _____	
3. Miscellaneous Property in Sec.	S _____ T _____ R _____	

Register of Deeds Stamp & File Number

4. Lot No. \_\_\_\_\_, Recorded Plat \_\_\_\_\_  
5. Private Claims \_\_\_\_\_

	A	B	C	D	E	F	G	H	I	J	K	L	M
2	6	5	4	3	2	1							
3													
4	7	8	9	10	11	12							
5													
6	18	17	16	15	14	13							
7													
8	19	20	21	22	23	24							
9													
10	30	29	28	27	26	25							
11													
12	31	32	33	34	35	36							
13													

I, Paul R. Bressette, in a field survey on November 7, 19 91, do hereby certify that under requirements of P.A. 74, Michigan P.A. of 1970, the corner points mentioned in lines 1 and 2 above were in conformance with regulations and rules therefore as required in the current manual of survey instructions of the United States Department of the Interior, Bureau of Land Management or by a decree of a Court of Law and/or that the corner points mentioned in lines 3, 4 and 5 above were in conformance with the rules of the Michigan Board of Land Surveyors or by a Decree of a Court of Law; established, re-established, monumented, re-monumented, recovered, found as expressed below:


NOTE: Not more than 4 corners, all in the same town and range, may be recorded on this certificate.

A. Description of original monument and accessories and/or subsequent restoration:

H-11. One Quarter corner common to Sections 27 and 34. Restored in 1980 by David B. Babbitt, RLS. Set 1" iron pipe with 4" aluminum cap witnessed by:  
8" H. Maple N 89° E 34.3'; 5" R. Maple S 66° E 18.8';  
4" H. Maple S 54° W 22.4'; 5" H. Maple N 52° W 17.0'.

B. Description of corner evidence found and/or method applied in restoring or reestablishing corner:

H-11. Reset monument from 1980 witnesses, all four alive and standing.

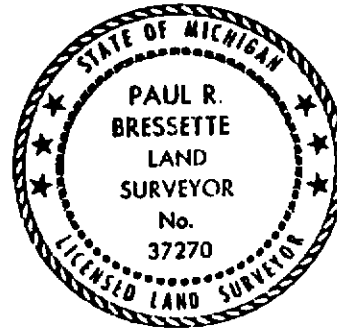

C. Description of monument for corner and accessories established to perpetuate locating the position of the corner:

H-11. 1" iron pipe with 4" aluminum cap.

10" H. Maple N 89° E 34.3'  
8" R. Maple S 66° E 18.8'  
6" H. Maple S 54° W 22.4'  
7" H. Maple N 52° W 17.0'  
Sq. Cedar post West 1.0'

Signed by Paul R. Bressette Date 9-18-92

Surveyor's Michigan License No. 37270