

RF

MAY 10 2000

# LAND CORNER RECORDATION CERTIFICATE

## Filing Requirement of Act 74, Mich. P.A. 1970

MARQUETTE COUNTY  
MICHIGAN  
RECEIVED FOR RECORD

1999 DEC 22 AM 11:24

For corners in SECTION  
MARQUETTE  
(County)

Located In:

Corner Code #

1. Public Land Survey

T. 45N R. 25WA-11/12 M.C. # 7T.    R.   

South shore

T. 45N R. 26WM-11/12 M.C. # 2T.    R.   

South shore

2. Property Controlling  
in SectionS.    T.    R.   S.    T.    R.   3. Miscellaneous  
Property in Sec.S.    T.    R.   S.    T.    R.   4. Lot No.           , Recorded Plat           5. Private Claims           
*Patricia A. Manley*  
REGISTER OF DEEDS
LIBER **R2** PAGE **192**

Register of Deeds Stamp &amp; File Number

I, GERALD W. CARLSON, in a field survey on May 27, 19 99, do hereby state that under requirements of P.A. 74, Michigan P.A. of 1970, the corner points mentioned in lines 1 and 2 above were in conformance with regulations and rules therefore as required in the current manual of survey instructions of the United States Department of the Interior, Bureau of Land Management or by a decree of a Court of Law and/or that the corner points mentioned in lines 3, 4 and 5 above were in conformance with the rules of the Michigan Board of Land Surveyors or by a Decree of a Court of Law; established, re-established, monumented, recovered, found as expressed below:

**NOTE:** Not more than 2 corners, all in the same town and range, may be recorded on this certificate.

### A. Description of original monument and accessories and/or subsequent restoration:

A-11/12: South Meander Corner common to Sections 31, T45N-R25W and Section 36, T45N-R26W.

1844: William A. Burt's original township boundary survey notes describe the corner monument as 12" W. Pine a referenced by:

7" Spruce S38W, 9L

No Date: A Survey sketch by R.A. Brotherton, C.E., indicates a meander corner 402' South of the Northwest corner of Section 31, T45N-R25W. No description of the monument or references given.

1953: A survey sketch by R.A. Brotherton, C.E., indicates a meander corner. No description or references given.

1985: Survey notes by Sundberg, Carlson and Associates, Inc., indicates a found 2" pipe at the meander corner location on the South side of Little Shag Lake.

### B. Description of corner evidence found and/or method applied in restoring or reestablishing corner:

A-11: 1998: No original corner evidence found. Found and accepted a 1 1/4" inside diameter iron pipe projecting 0.1' above ground at top of bank and +/- 25' higher than water elevation. Distance North is 1005.83', South is 1241.77'.

### C. Description of monument for corner and accessories established to perpetuate locating the position of the corner:

A-11: 1998: Replaced the existing monument with a 2 3/8" O.D. aluminum pipe capped with a 3 1/4" diameter aluminum tablet Marquette County Survey Monument stamped to identify the corner. Monument is flush with the ground. Referenced by:

N.W. corner of N.W. pad of porch foundation	S15E, 25.32'	8" Red Pine	N51W, 2.52'
South shore Little Shag Lake	North, 25.0'	12" Red Pine	S70E, 5.83'
11" Twin Red Pine	S58W 8.31'	5" Red Pine	S25W 15.19'
Green Steel Sign Post w/ Yellow Survey Marker Sign		North,	1.23'

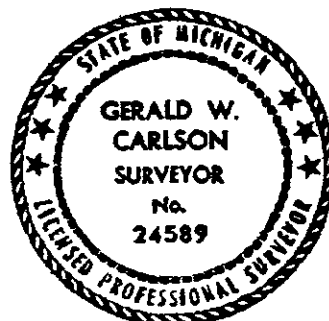
Note: Bearing trees have d.h. nails. No blazes or B.T. tags.

T45N-R25W Corner Search Report 99100

	A	B	C	D	E	F	G	H	I	J	K	L	M
1													
2	6		5		4		3		2		1		
3													
4	7		8		9		10		11		12		
5													
6	18		17		16		15		14		13		
7													
8	19		20		21		22		23		24		
9													
10	30		29		28		27		26		25		
11													
12	31		32		33		34		35		36		
13													

RATIFIED BY PEER COUNCIL

P.A. 345 OF 1990

*Larry J. Busan*  
DATE 10/25/99
Signed by Gerald W. CarlsonDate 12-8-99Surveyor's Michigan License No. 24589

FORM APPROVED BY MICHIGAN STATE BOARD OF PROFESSIONAL SURVEYORS, JAN. 28, 1971

REVISED MAY 14, 1975

REVISED JAN., 1983

REVISED OCT., 1995