

MICHIGAN
DEPARTMENT OF CONSERVATION
FORESTRY DIVISION

✓

LAND CORNER RECORD

T. 45N N.R. 27W


Marquette COUNTY

DESCRIPTION OF CORNER North 1/16 corner bet. Secs. 33-34

CORNER MONUMENT 1" pipe with 4" aluminum cap.

DATE MONUMENT PLACED AND WITNESSED 8/15/66

WITNESSES TO CORNER..... 10" red pine (BT) S40°W 33.3'

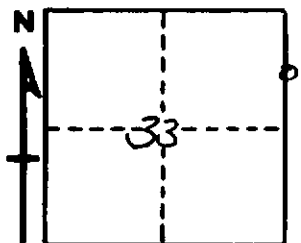

8" jack pine (BT) S30°E 42.0'

AND

CIRCLE CORNER REGISTERED

DESCRIPTION IN DETAIL AS TO HOW CORNER WAS LOCATED AND IDENTIFIED OR RESTORED.

This corner placed midway bet. Sec. Cor. to north and 1/4 cor. to south.

Corner lies 3 chs. north of Kates Grade Truck Trail.

SURVEYOR'S SEAL

SIGNED Billy D. Buckler DATE 1/10/67
REGISTERED LAND SURVEYOR