

MICHIGAN
DEPARTMENT OF CONSERVATION
FORESTRY DIVISION

LAND CORNER RECORD

T. 45N N.R. 27W


Marquette COUNTY

DESCRIPTION OF CORNER Sec. Cor. common to Sections 29-30-31-32

CORNER MONUMENT 1" pipe with 4" aluminum cap.

DATE MONUMENT PLACED AND WITNESSED 7/19/66

WITNESSES TO CORNER..... 8" soft maple - West - 49.5'

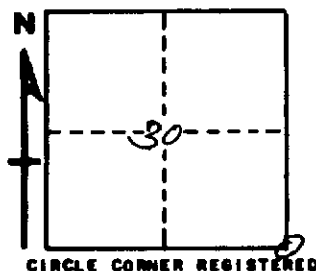

6" soft maple N 76°E 39.0'

AND

DESCRIPTION IN DETAIL AS TO HOW CORNER WAS LOCATED AND IDENTIFIED OR RESTORED.

This corner re-established by double proportionate measure from corners; 1 mile North; 1 mile South; 1 mile East and 1 mile West.

Found no original evidence.

Corner lies on steep side hill, facing to north.

SURVEYOR'S SEAL

SIGNED Billy D. Buckler DATE 1/9/67
REGISTERED LAND SURVEYOR