

# SURVEY & REMONUMENTATION

MAR 13 1998

SECTION

## LAND CORNER RECORDATION CERTIFICATE Filing Requirement of Act 74, Mich. P.A. 1970

MARQUETTE COUNTY  
MICHIGAN  
RECEIVED FOR RECORD

1997 DEC 30 PM 1:45

For corners in

MARQUETTE

(County)

Located In:

Corner Code #

1. Public Land Survey

T 46N R 25W

T 46N R 24W

T R

T R

2. Property Controlling  
in Section

S T R

S T R

3. Miscellaneous

S T R

Property in Sec.

S T R

4. Lot No. , Recorded Plat

5. Private Claims

*Patricia R. Monney*  
REGISTER OF DEEDS

LIBER

2 PAGE 55

Register of Deeds Stamp & File Number

I, GERALD W. CARLSON, in a field survey on DECEMBER 23RD, 19 97, do hereby state that under requirements of P.A. 74, Michigan P.A. of 1970, the corner points mentioned in lines 1 and 2 above were in conformance with regulations and rules therefore as required in the current manual of survey instructions of the United States Department of the Interior, Bureau of Land Management or by a decree of a Court of Law and/or that the corner points mentioned in lines 3, 4 and 5 above were in conformance with the rules of the Michigan Board of Land Surveyors or by a Decree of a Court of Law; established, re-established, monumented, recovered, found as expressed below:

NOTE: Not more than 2 corners, all in the same town and range, may be recorded on this certificate.

### A. Description of original monument and accessories and/or subsequent restoration:

M-3: Section Corner common to Sections 1 and 12, T46N-R25W, and Sections 6 and 7, T46N-R24W.

1844: William A. Burt's original survey notes describe the corner monument as a wood post referenced by:

16" Sugar S87W, 31 L 5" Maple N28E, 20 L

1845: William Ives' original subdivision survey notes for T46N-R24W indicate the following additional references to the corner monument:

16" Sugar S28E, 54 L 7" Maple N29E, 18 L

No further corner information available.

### B. Description of corner evidence found and/or method applied in restoring or reestablishing corner:

M-3: 1997: No original corner evidence found. Survey control was established along the East Township Line (T46N-R25W) from the N.E. Corner of Section 36 to the N.E. Corner of Section 1. No evidence of existing corners was found along this 5 mile section of Range Line. Various cruisers paint lines, location posters and GLO Line Calls were tied in along the entire 5 mile route. This 5 mile section of line measured 136 feet short from the GLO measurement from the N.E. Corner of Section 36 to the N.E. Corner of Section 1. It was decided at the December 15, 1997 Peer Group meeting to proportion the East 1/4 Corner of Section 1 between the stream call 116' South of the East 1/4 Corner of Section 1 and the N.E. Corner of Section 1. The remaining of corners South of the East 1/4 Corner of Section 1 were proportioned to the N.E. Corner of Section 36. Each 1/2 mile distance was 2632.72' by using this proportion. The East-West position of the N.E. Corner of Section 13 was Placed 231' West (GLO - 3.5 chains) of the centerline of the stream call East. This put a slight bend in the Straight line as the N.E. Corner of Section 13 was placed 29.10' West of this calculated straight line from N.E. Corner of Section 36 to the N.E. Corner of Section 1. The remaining stream calls fit extremely well to the proportioned corners. The distances West to the N.W. and S.W. Corners of Section 13 and the South 1/4 Corner of Section 24 also fit extremely well to the GLO distances. Distance North is 2632.74' and distance South is 2632.74'.

### C. Description of monument for corner and accessories established to perpetuate locating the position of the corner:

M-3: 1997: Set a 2 3/8" O.D. aluminum pipe capped with a 3 1/4" diameter aluminum tablet Marquette County Survey Monument stamped to identify the corner. Monument is 0.2' above ground. Established new references (to set d.h. nails):

8" Maple N58W, 14.03'

8" Maple N38E, 12.27'

6" Maple S03E, 14.82'

7" Maple S38W, 24.31'


Green Steel Sign Post w/ Yellow Survey Marker Sign S15W, 3.2'

Note: Bearing trees have painted face, butt, and side nail blazes, d.h. measuring nails, and stamped B.T. Tags affixed.

Bk. 14, Pg. 79-84

RATIFIED BY PEER GROUP  
P.A. 345 OF 1990

*Larry J. Burome*  
DATE 12/15/97

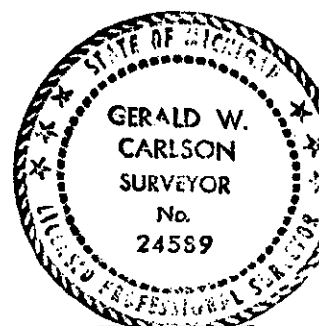

Signed by

*Gerald W. Carlson*

Date

12-24-97

Surveyor's Michigan License No. 24589

FORM APPROVED BY MICHIGAN STATE BOARD OF PROFESSIONAL SURVEYORS. JAN. 28, 1971  
REVISED MAY 14, 1975  
REVISED JAN., 1983