

MICHIGAN
DEPARTMENT OF CONSERVATION
FORESTRY DIVISION

LAND CORNER RECORD

T. 46 N.R. 27W


Marquette COUNTY

DESCRIPTION OF CORNER 1/4 Corner between Sections 27-28

CORNER MONUMENT 1" Pipe with 4" Aluminum Cap

DATE MONUMENT PLACED AND WITNESSED 5/19/67

WITNESSES TO CORNER..... 10" B. Oak (Clump) 1/4 S NBT) 33.0' S82°E

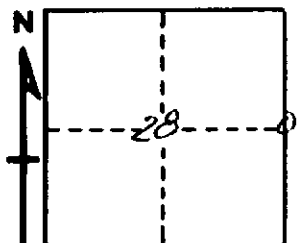

7" Jack Pine (1/4 S NBT) S22°E 46.5'

AND

CIRCLE CORNER REGISTERED

DESCRIPTION IN DETAIL AS TO HOW CORNER WAS LOCATED AND IDENTIFIED OR RESTORED.

This corner replaced from remains of a Y. Pine (possible B.T.) bearing S51°W, 20 links. Found no other y. pines near corner location.

Corner lies 2 chains north of a ravine, course p-.

SURVEYOR'S SEAL

SIGNED Billy D. Buckles DATE 12/21/67.
REGISTERED LAND SURVEYOR