

1999 DEC 22 AM 11: 26

Patricia R. Montoye
REGISTER OF DEEDS

SECTION

LAND CORNER RECORDATION CERTIFICATE
Filing Requirement of Act 74, Mich. P.A. 1970

For corners in

MARQUETTE

(County)

Located In:

Corner Code #

1. Public Land Survey T 47N R 25W D-13
T R
T R
T R
T R
2. Property Controlling S T R
in Section S T R
3. Miscellaneous S T R
Property in Sec. S T R
4. Lot No. , Recorded Plat
5. Private Claims

LIBER **R2** PAGE **218**
Register of Deeds Stamp & File Number

I, GERALD W. CARLSON, in a field survey on October 28th, 19 99, do hereby state that under requirements of P.A. 74, Michigan P.A. of 1970, the corner points mentioned in lines 1 and 2 above were in conformance with regulations and rules therefore as required in the current manual of survey instructions of the United States Department of the Interior, Bureau of Land Management or by a decree of a Court of Law and/or that the corner points mentioned in lines 3, 4 and 5 above were in conformance with the rules of the Michigan Board of Land Surveyors or by a Decree of a Court of Law; established, re-established, monumented, recovered, found as expressed below:

NOTE: Not more than 2 corners, all in the same town and range, may be recorded on this certificate.

A. Description of original monument and accessories and/or subsequent restoration:**D-13: South Quarter Corner to Section 32, T47N-R25W.**

1844: William A. Burt's original township boundary survey notes describe the corner monument as a wood post referenced by:

5" S. Pine N17E, 27L 4" S. Pine N58W, 17L

1877: A railroad map for Chicago and Northwestern railroad, indicates the corner is 339' East of the centerline of the railroad.

1986: A section breakdown calculation sheet by Gerry Carlson P.S.# 24589, indicates the corner distance S89-56-19E, 2635.77' to the Southeast corner and distance N89-56-19W, 2635.77' to the Southwest corner of Section 32, T47N-R25W.

B. Description of corner evidence found and/or method applied in restoring or reestablishing corner:**D-13: 1999:** No original evidence found. Corner position established by single proportionate measurement on a latitudinal curve between the Southwest corner of Section 31 and the Southeast corner of Section 32, T47N-R25W. Distances are 2636.30' West and 2636.30' East along the South township line of T47N-R25W to the Southwest and Southeast corners of Section 32. The North quarter corner of Section 5, T46N-R25W is West 24.44'.**C. Description of monument for corner and accessories established to perpetuate locating the position of the corner:****D-13: 1999:** Set a 2 3/8" O.D. aluminum pipe capped with a 3 1/4" diameter aluminum tablet Marquette County Survey Monument stamped to identify the corner. Monument is 0.20' above ground. Referenced by:

11" Jack Pine	N21W,	30.04'	7" Jack Pine	N51E,	28.52'
10" Jack Pine	S81E,	52.64'	6" Jack Pine	S14W,	36.69'
N 1/4 Section 5 46-25 (cc)	N90W,	24.42'			

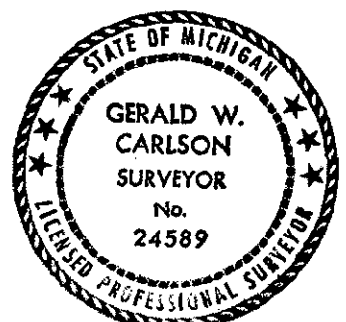
Green Steel Sign Post w/ Yellow Survey Marker Sign N04W, 1.89'

Note: Bearing trees have painted face, butt, and side nail blazes, d.h. measuring nails, and stamped B.T. Tags affixed.

Bk. 12, Pg. 94 T46N-R25W Corner Search Sheet 99100

Bk. 12, Pg. 132

	A	B	C	D	E	F	G	H	I	J	K	L	M
1													
2	6		5		4		3		2		1		
3													
4	7		8		9		10		11		12		
5													
6	18		17		16		15		14		13		
7													
8	19		20		21		22		23		24		
9													
10	30		29		28		27		26		25		
11													
12	31		32		33		34		35		36		
13													

RATIFIED BY PEER GROUP
P.A. 345 OF 1990DATE 11/1/99

Signed by

Gerald W. Carlson

Date

12-8-99Surveyor's Michigan License No. 24589