

SURVEY &
REMONUMENTATION

JOB NUMBER: 94030

SHEET NO. : 1-526

For corners in

APR 28 1995

LAND CORNER RECORDATION CERTIFICATE

Filing Requirement of Act 74, Mich. P.A. 1970

COMMISSION

MARQUETTE COUNTY
MICHIGAN
RECEIVED FOR RECORD

1994 DEC 28 PM 5:58

Patricia L. Mendenhall
REGISTER OF DEEDS

MARQUETTE (County)	Located In:	Corner Code #
1. Public Land Survey	T 47N R 26W	I-1
	T R	
	T R	
	T R	
2. Property Controlling in Section	S T R	
	S T R	
3. Miscellaneous Property in Sec.	S T R	
	S T R	

LIBER 1 PAGE 192
Register of Deeds Stamp & File Number

4. Lot No. _____, Recorded Plat _____
5. Private Claims _____

GERALD W. CARLSON, in a field survey on Wednesday, November 23, 1994, do hereby certify that under requirements of P.A. 74, Michigan P.A. of 1970, the corner points mentioned in lines 1 and 2 above were in conformance with regulations and rules therefore as required in the current manual of survey instructions of the United States Department of the Interior, Bureau of Land Management or by a decree of a Court of Law and/or that the corner points mentioned in lines 3, 4 and 5 above were in conformance with the rules of the Michigan Board of Land Surveyors or by a Decree of a Court of Law, established, re-established, monumented, re-monumented, recovered, found as expressed below:

NOTE: Not more than 4 corners, all in the same town and range, may be recorded on this certificate.

	A	B	C	D	E	F	G	H	I	J	K	L	M
2	6	5	4	3	2	1							
3													
4	7	8	9	10	11	12							
5													
6	18	17	16	15	14	13							
7													
8	19	20	21	22	23	24							
9													
10	30	29	28	27	26	25							
11													
12	31	32	33	34	35	36							
13													

A. Description of original monument and accessories and/or subsequent restoration:

I-1: Section Corner common to Sections 2 and 3, T47N-R26W.
1845: Sam Hill's original survey notes describe the corner monument as a wood post 15 l East of the Section Corner common to Sections 34 and 35, T48N-R26W, referenced by:

White Pine, S3.30 ch., No other bearing convenient.
1912: County survey by Charles Cummings indicates Northwest Corner Section 2 as an iron stake. No corner accessories given.

1931: Marquette County Road Commission field book 385, indicates a steel rail at the Northwest Corner of Section 2, T47N-R26W located about 8 feet South of LS&I railroad fence found a decayed Tamarack stump that corresponds with B.T. Tamarack 12, N19E, 240 l. (US Field Notes) on North side of railroad fence. Other B.T. destroyed in making R.R. fill. The B.T. referenced in above note is for the Corner common to Sections 34 and 35, T48N-R26W.

B. Description of corner evidence found and/or method applied in restoring or reestablishing corner:

1994: Found and accepted the 5/8" re-rod w/LLS cap as referenced above in Part A.
Distance West is 2634.08' and distance East is 5220.68'.
The Section Corner common to Sections 34 and 35, T48N-R26W is West 9.96'.

RATIFIED BY PEER GROUP
P.A. 345 OF 1990

Larry J. Busone
DATE Nov 7, 1994

C. Description of monument for corner and accessories established to perpetuate locating the position of the corner:


1994 - Replaced 5/8" iron and cap #24589 with a 2 1/2" diameter aluminum pipe capped with a 3 1/4" diameter aluminum tablet Marquette County Survey Monument stamped to identify the corner referenced by nails in:

4" Black Ash S47W 28.02 ft.
6" White Birch S76W 112.92 ft. Carlson NBT
5" Maple S87W 74.26 ft. Carlson NBT
7" White Birch N54E 63.72 ft.
Steel sign post S32E 0.71 ft.

Monument is 0.35' above ground at edge of swamp 43' South of centerline of South RR rails and 199' East of Cass River.
Bk. 7, Pg. 141

Signed by *Gerald W. Carlson* Date 12-22-94
Surveyor's Michigan License No. _____

FORM APPROVED BY MICHIGAN STATE BOARD OF LAND SURVEYORS, JAN. 14, 1975
24589 REVISED JAN. 1983

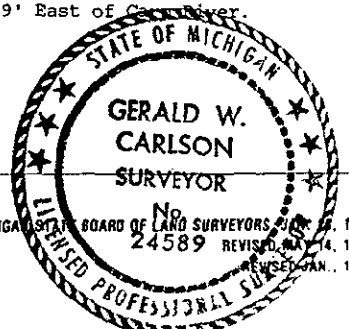

Record No. 526:

Part "A" Continued:

1993: Land Corner Recordation Certificate filed by Gerald W. Carlson, PS #24589 set a 5/8 rerod with LLs cap 24589, 9.90' (15 l) East of railroad rail on line between SW and SE Corners of Section 35, T48N-R25W, l-13 and K-13. This position make nearly a straight line with the West 1/4 and Southwest Corner of Section 2. Referenced by:

4" Maple,	S75W,	74.31'
6" Birch,	S68W,	112.94'

Centerline South rail of South set of railroad tracks, N32W, 41.71'
Found railroad rail (l-13) (T48N-R26W), N87W, 9.90'.