

1893

COMMISSION

JOB NUMBER: 93300
SHEET NO. : 1-393

LAND CORNER RECORDATION CERTIFICATE
Filing Requirement of Act 74, Mich. P.A. 1970

For corners in

MARQUETTE
(County)

Located In:

Corner Code ##

1. Public Land Survey

T 47N R 27W
T 48N R 27W

MC D/E-1

MC D/E-13

2. Property Controlling
in Section

S T R
S T R

3. Miscellaneous
Property in Sec.

S T R
S T R

#1

LIBER

1 PAGE 94

Register of Deeds Stamp & File Number

4. Lot No. _____, Recorded Plat _____

5. Private Claims _____

I, GERALD W. CARLSON, in a field survey on Wednesday, December 29, 1993

do hereby certify that under requirements of P.A. 74, Michigan P.A. of 1970, the corner points mentioned in lines 1 and 2 above were in conformance with regulations and rules therefore as required in the current manual of survey instructions of the United States Department of the Interior, Bureau of Land Management or by a decree of a Court of Law and/or that the corner points mentioned in lines 3, 4 and 5 above were in conformance with the rules of the Michigan Board of Land Surveyors or by a Decree of a Court of Law; established, re-established, monumented, re-monumented, recovered, found as expressed below:

NOTE: Not more than 4 corners, all in the same town and range, may be recorded on this certificate.

A. Description of original monument and accessories and/or subsequent restoration:

MC D/E-1: Meander Corner east of Quarter Corner common to
Section 5, T47N-R27W and Section 32, T48N-R27W. 1846:
Austin Burt's original survey notes describe the corner

monument as a wood post referenced by:

12" W.Pine S57.75E, 28.1
7" Tamarack N67.5E, 55.1
(East side of Cooper Lake).

B. Description of corner evidence found and/or method applied in restoring or reestablishing corner:

1993 - Meander corner was calculated proportional distance and on line between the NE corner and the NW corner of
Section 5, T47N-R27W.


C. Description of monument for corner and accessories established to perpetuate locating the position of the corner:

1993 - Set a 2 1/8" diameter aluminum pipe capped with a 3 1/4" diameter aluminum tablet Marquette County Survey
Monument stamped to identify the corner referenced by nails in:

14" Spruce N74E 14.49 ft.
16" Jack Pine S40E 33.37 ft.
10" Jack Pine S54W 31.14 ft.
18" White Pine N44W 23.87 ft.

Monument is 0.30 ft. above grade, 13.5 ft. South of a fence and 160 ft. East and
33 ft. South of the water's edge of Cooper Lake.

Bk. 5, Pg. 38

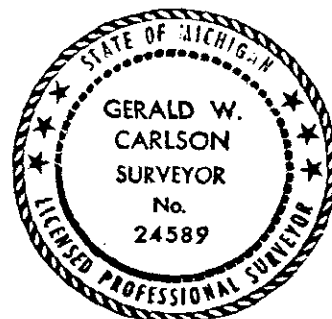

Signed by Gerald W. Carlson

Date 12-29-93

Surveyor's Michigan License No. 24589