

SURVEY &
REMONUMENTATION

APR 28 1995

JOB NUMBER: 94030
SHEET NO. : 1-515
For corners in

COMMISSION LAND CORNER RECORDATION CERTIFICATE
Filing Requirement of Act 74, Mich. P.A. 1970

MARQUETTE COUNTY
MICHIGAN
RECEIVED FOR RECORD

1994 DEC 28 PM 5:58

Patricia A. Muehl
REGISTER OF DEEDS

MARQUETTE
(County)

Located In: Corner Code ##

1. Public Land Survey T 48N R 26W D13
T R
T R
T R

2. Property Controlling S T R
in Section S T R

3. Miscellaneous S T R
Property in Sec. S T R

LIBER 1 PAGE 181
Register of Deeds Stamp & File Number

4. Lot No. , Recorded Plat
5. Private Claims

I, GERALD W. CARLSON, in a field survey on Wednesday, December 21, 1994, do hereby certify that under requirements of P.A. 74, Michigan P.A. of 1970, the corner points mentioned in lines 1 and 2 above were in conformance with regulations and rules therefore as required in the current manual of survey instructions of the United States Department of the Interior, Bureau of Land Management or by a decree of a Court of Law and/or that the corner points mentioned in lines 3, 4 and 5 above were in conformance with the rules of the Michigan Board of Land Surveyors or by a Decree of a Court of Law; established, re-established, monumented, re-monumented, recovered, found as expressed below:

NOTE: Not more than 4 corners, all in the same town and range, may be recorded on this certificate.

	A	B	C	D	E	F	G	H	I	J	K	L	M
2	6	5	4	3	2	1							
3													
4	7	8	9	10	11	12							
5													
6	18	17	16	15	14	13							
7													
8	19	20	21	22	23	24							
9													
10	30	29	28	27	26	25							
11													
12	31	32	33	34	35	36							
13													

A. Description of original monument and accessories and/or subsequent restoration:

D-13: South 1/4 Corner Section 32, T48N-R26W.
1844: William A. Burt's original survey notes described corner monument as a wood post. Referenced by:
7" Spruce, N54E, 33 l
10" Cedar, N44W, 8 l
No date given: Maas triangulation coordinates obtained from CCI indicate the North 1/4 Corner Section 5, T47N-R26W as South 70.40, East 2635.17.

1978: Certificate of Survey by Joseph Wasie, RLS #15415, recorded in Liber 328, Page 692, indicates the North 1/4 Corner of Section 5 as a found 1" iron pin.
Referenced by:
6" Poplar S20E 59.44 ft.
4" Poplar S71W 51.98 ft.
6" Poplar N31W 65.95 ft.
(See reverse side.)

B. Description of corner evidence found and/or method applied in restoring or reestablishing corner:

1994: Found and accepted the 1" iron pin as referenced above in part "A". Distance West is 2635.84' and distance East is 2647.48'. These distances compare well with the rest of the township line, indicating the found pin to be the South 1/4 Corner of Section 32. The North 1/4 Corner of Section 5, T47N-R26W is East, 51.03'.

RATIFIED BY PEER GROUP
P.A. 345 OF 1990


Larry J. Bussone
DATE Nov 7, 1994

C. Description of monument for corner and accessories established to perpetuate locating the position of the corner:

1994 - Replaced 3/4" inside diameter pipe with a 5.1' long, 3/4" diameter re-rod capped with a 3 1/4" diameter aluminum tablet Marquette County Survey Monument stamped to identify the corner referenced by nails in:
7" Poplar N65E 152.79 ft.
6" Poplar N20E 94.23 ft.
9" Poplar S85W 90.91 ft.
5" Poplar S02W 67.17 ft.
Face of 6" diameter, 5.4' high metal test well casing S70E 100.67 ft. "Hakala Well & Pump Negaunee, MI"
Steel sign post N09W 2.08 ft.
Monument is 0.8' above ground and in swampy area of Poplar and small brush. Bk. 6, Pg. 151

Signed by Gerald W. Carlson Date 12-28-94
Surveyor's Michigan License No. 24589

FORM APPROVED BY MICHIGAN STATE BOARD OF LAND SURVEYORS, JAN. 28, 1977
REVISED MAY 12, 1977
REVISED JAN., 1981

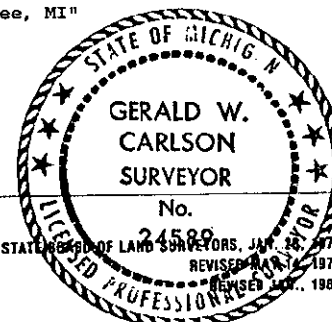

Record No. 515:

Part "A" Continued:

This corner was referred to as both the South 1/4 Section 32, and the North 1/4 of Section 5, which is in error because of double corners at this location.

X# 6446
Geo
2100 1/2