

1993

COMMISSION

MARQUETTE COUNTY
MICHIGAN
RECEIVED FOR RECORD

JOB NUMBER: 93300

SHEET NO. : 1-328

For corners in

LAND CORNER RECORDATION CERTIFICATE
Filing Requirement of Act 74, Mich. P.A. 1970

1993 DEC 22 PM 4:12

Robert A. Marley
REGISTERED
10

Liber 1 R.C. Page 31

Register of Deeds Stamp & File Number

MARQUETTE (County)		Located In:	Corner Code #
1. Public Land Survey	T 49N R 25W	A-13	
	T 49N R 26W	M-13	✓
	T 48N R 25W	A-1	
	T 48N R 26W	M-1	
2. Property Controlling in Section	S T R		
3. Miscellaneous Property in Sec.	S T R		
4. Lot No. _____	Recorded Plat _____		
5. Private Claims _____			

I, GERALD W. CARLSON, in a field survey on Tuesday, November 30, 1993, do hereby certify that under requirements of P.A. 74, Michigan P.A. of 1970, the corner points mentioned in lines 1 and 2 above were in conformance with regulations and rules theretofore as required in the current manual of survey instructions of the United States Department of the Interior, Bureau of Land Management or by a decree of a Court of Law and/or that the corner points mentioned in lines 3, 4 and 5 above were in conformance with the rules of the Michigan Board of Land Surveyors or by a Decree of a Court of Law, established, re-established, monumented, re-monumented, recovered, found as expressed below:

NOTE: Not more than 4 corners, all in the same town and range, may be recorded on this certificate.

A. Description of original monument and accessories and/or subsequent restoration:


A-13: Section Corner common to Section 6, T48N-R25W; Section 31, T49N-R25W; Section 1, T48N-R26W; Section 36, T49N-R26W. 1988 - G. Carlson found and iron with LS cap #15413 and #25836 referenced by:
1845: William A. Burt's original survey notes describe the corner monument as a wood post referenced by:
8" Sugar S72E, 36 l
14" Hemlock N53W, 38 l
14" Spruce S55W 8.13 ft.
11" Hemlock N49W 11.98 ft.
9" White Birch S68E 13.10 ft.
12" Maple S07E 22.81 ft.
LS RC, Pg. 153.

B. Description of corner evidence found and/or method applied in restoring or reestablishing corner:

1993 - Found a iron and cap with LS #'s 15413 and 25836 replaced with Marquette County Survey Monument. The surveyor's notes who placed the corner were examined and it was the peer group's consensus that a reasonable and prudent job was performed in establishing this corner according to original G.L.O. evidence and the corner position was accepted. Peer group ratification 11-29-93.

C. Description of monument for corner and accessories established to perpetuate locating the position of the corner:

1993 - Replaced iron with LS cap #15413 & #25836 with 2 1/8" diameter aluminum pipe capped with 3 1/4" diameter aluminum tablet Marquette County Survey Monument stamped to identify the corner referenced by nails in:
11" Hemlock N37W 12.03 ft. Carlson NBT
9" White Birch S65E 13.12 ft. Carlson NBT
13" Maple S16E 22.81 ft. Carlson NBT
14" Spruce S61W 8.20 ft. Carlson NBT
Monument is 0.50 ft. above ground.
Bk. 3, pg. 108

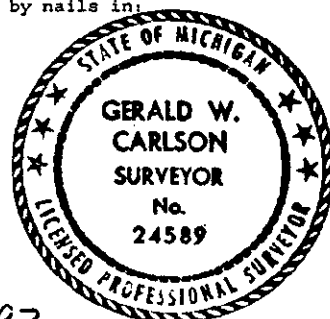

Signed by Gerald W. Carlson

Date 12-22-93

Surveyor's Michigan License No. 24589