

MAY 22 1997

COMMISSION

**LAND CORNER RECORDATION CERTIFICATE**  
Filing Requirement of Act 74, Mich. P.A. 1970

MARQUETTE COUNTY  
MICHIGAN  
RECEIVED FOR RECORD

1996 NOV 22 AM 11:06

For corners in

Marquette

(County)

Located In:

Corner Code #

1. Public Land Survey

T 50N R 28W

83

2. Property Controlling  
in Section

S

T

R

3. Miscellaneous  
Property in Sec.

S

T

R

S

T

R

*Patricia A. Munkley*  
REGISTER OF DEEDS

LIBER

1 PAGE 310

Register of Deeds Stamp & File Number

4. Lot No. \_\_\_\_\_, Recorded Plat \_\_\_\_\_

5. Private Claims \_\_\_\_\_

Sep 06 1995

I, Stephan J. Szyszkoski, in a field survey on \_\_\_\_\_, 19\_\_\_\_ do hereby state that under requirements of P.A. 74, Michigan P.A. of 1970, the corner points mentioned in lines 1 and 2 above were in conformance with regulations and rules therefore as required in the current manual of survey instructions of the United States Department of the Interior, Bureau of Land Management or by a decree of a Court of Law and /or that the corner points mentioned in lines 3, 4 and 5 above were in conformance with the rules of the Michigan Board of Land Surveyors or by a Decree of a Court of Law; established, re-established, monumented, recovered, found as expressed below:

NOTE: Not more than 2 corners, all in the same town and range, may be recorded on this certificate.

	A	B	C	D	E	F	G	H	I	J	K	L	M
1													
2	6		5		4		3		2		1		
3													
4	7		8		9		10		11		12		
5													
6	18		17		16		15		14		13		
7													
8	19		20		21		22		23		24		
9													
10	30		29		28		27		26		25		
11													
12	31		32		33		34		35		36		
13													

A. Description of original monument and accessories and/or subsequent restoration:

(83) Quarter corner common to Sections 6-7. Corner established in 1852 by Abner B. Wood: "East corrected between Sec. 6-7...39.80 Set quarter section post Maple 14 S40W 46, Maple 14 N32E 28". Found no subsequent record.

B. Description of corner evidence found and/or method applied in restoring or reestablishing corner:

(83) Original post and accessories not recovered. Found no acceptable evidence of the position of the original corner on the ground. Reestablished the corner on a straight line between original section corners 2638.61' east and 2625.41' west, being proportionate to the original record. At the position for the corner, I placed a 1"IDx32" iron pipe capped with a 4" dia. cast aluminum MDNR tablet, appropriately stamped.

RATIFIED BY PEER GROUP  
P.A. 345 OF 1990

*Larry J. Bussan*  
DATE 10/28/96

C. Description of monument for corner and accessories established to perpetuate locating the position of the corner:


(83) Set 1" pipe with 4" MDNR cap.  
Blazed and scribed the following new bearing trees:

12" Sugar N47W 11.9' "1/4S N8T"  
20" Sugar S32W 14.4' "1/4S N8T"  
5" Sugar S44E 16.5' "1/4S N8T"  
14" Sugar N59E 25.5' "1/4S N8T"

Bearings are magnetic.

MDNR monuments are 1"IDx32" iron pipe capped with a 4" dia. cast aluminum Michigan Department of Natural Resources tablet, stamped with Township, Range, corner ID, date of placement, and "PS 33986".

New bearing trees are marked with a 8H blaze and a lower blaze at the root crown. The blazes are scribed as indicated in quotation marks at left, with N8T or BT (as noted) being on the lower blaze. Distances are horizontal (unless noted) and measured from the corner to the inside of a notch cut into the bottom of the lower blaze.

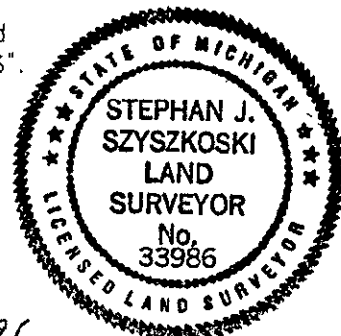

Signed by Stephan J. Szyszkoski  
Surveyor's Michigan License No. 33986

Date 11-5-96

For the Michigan Department of Natural Resources - Forest Management Division