

SURVEY &
REMONUMENTATION

OCT 26 1993

COMMISSION

LAND CORNER RECORDATION CERTIFICATE
Filing Requirement of Act 74, Mich. P.A. 1970

Approved by Menominee County
Land Survey Remonumentation
Peer Group Under Act 345 Of

P.A. Of 1990 On OCT 6, 1993

McL Davis RLS


For corners in

MENOMINEE
(County)

Located In:

Corner Code ##

1. Public Land Survey T 32N R 27W H-5
T _____ R _____
T _____ R _____
T _____ R _____
2. Property Controlling S _____ T _____ R _____
in Section S _____ T _____ R _____
3. Miscellaneous S _____ T _____ R _____
Property in Sec. S _____ T _____ R _____
4. Lot No. _____, Recorded Plat _____
5. Private Claims _____

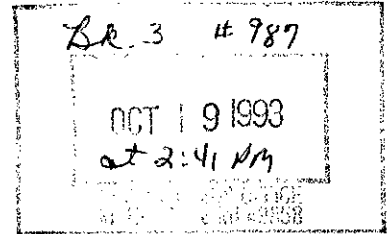

Register of Deeds Stamp & File Number

I, William Lenca, in a field survey on Sept., 1993, do hereby certify that under requirements of P.A. 74, Michigan P.A. of 1970, the corner points mentioned in lines 1 and 2 above were in conformance with regulations and rules therefore as required in the current manual of survey instructions of the United States Department of the Interior, Bureau of Land Management or by a decree of a Court of Law and/or that the corner points mentioned in lines 3, 4 and 5 above were in conformance with the rules of the Michigan Board of Land Surveyors or by a Decree of a Court of Law; established, re-established, monumented, re-monumented, recovered, found as expressed below:

NOTE: Not more than 4 corners, all in the same town and range, may be recorded on this certificate.

A. Description of original monument and accessories and/or subsequent restoration:

ORIGINAL B.T.'s:

Tamarack, 10", S55°E, 05 lks
Tamarack, 10", N28°W, 07 lks

Original Survey by James H. Mullett in 1848. All original evidence for this corner has been destroyed by clearing and ditching activities.

B. Description of corner evidence found and/or method applied in restoring or reestablishing corner:

Found 2½" Brass cap on 2" Iron Pipe 46.6 feet West of old fence running South, and 26.7 feet South of centerline of Elmwood Road. This corner was perpetuated by George B. Wilson, RLS 17607, in 1976. Mr. Wilson found a 1" dia. Iron Pipe and an old wood stake at this location, which he states he believes to be 50 to 70 years old. This corner was previously recorded in Book 1 of Land Corner Records on page 140, and is accepted as the best available evidence of the position of the original corner.

C. Description of monument for corner and accessories established to perpetuate locating the position of the corner:

Found 2" dia. Iron Pipe/2½" Brass Cap stamped for corner:

5" Tamarack,	N40°E	89.97 feet
6" dia. Tamarack	S38°E	24.32 feet
6" dia. Tamarack	S21°W	32.19 feet
4" dia. Soft Maple	N32°W	102.60 feet
Steel Fence Post	South	0.8 feet

NOTE: All bearings are magnetic bearings; all distances are measured with steel tape; distances to trees are to nail in center of tree.

Signed by William Lenca

Date Sept. 22, 1993

Surveyor's Michigan License No. 26461