

SURVEY &  
REMONUMENTATION

OCT 26 1993

COMMISSION

LAND CORNER RECORDATION CERTIFICATE  
Filing Requirement of Act 74, Mich. P.A. 1970

Approved by Menominee County  
Land Survey Remonumentation  
Peer Group Under Act 345 Of

P.A. Of 1990 On OCT 6 1993

McL. ADAM RLS  
Chairman (ACTING)


For corners in

MENOMINEE  
(County)

Located In:

Corner Code #/

1. Public Land Survey T 32N R 27W K-5  
T \_\_\_\_\_ R \_\_\_\_\_  
T \_\_\_\_\_ R \_\_\_\_\_  
T \_\_\_\_\_ R \_\_\_\_\_  
2. Property Controlling S \_\_\_\_\_ T \_\_\_\_\_ R \_\_\_\_\_  
in Section S \_\_\_\_\_ T \_\_\_\_\_ R \_\_\_\_\_  
3. Miscellaneous S \_\_\_\_\_ T \_\_\_\_\_ R \_\_\_\_\_  
Property in Sec. S \_\_\_\_\_ T \_\_\_\_\_ R \_\_\_\_\_  
4. Lot No. \_\_\_\_\_, Recorded Plat \_\_\_\_\_  
5. Private Claims \_\_\_\_\_

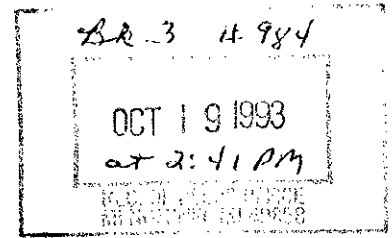

Register of Deeds Stamp & File Number

I, William Lenca, in a field survey on Sept., 1993, do hereby certify that under requirements of P.A. 74, Michigan P.A. of 1970, the cornerpoints mentioned in lines 1 and 2 above were in conformance with regulations and rules therefore as required in the current manual of survey instructions of the United States Department of the Interior, Bureau of Land Management or by a decree of a Court of Law and/or that the corner points mentioned in lines 3, 4 and 5 above were in conformance with the rules of the Michigan Board of Land Surveyors or by a Decree of a Court of Law; established, re-established, monumented, re-monumented, recovered, found as expressed below:

NOTE: Not more than 4 corners, all in the same town and range, may be recorded on this certificate.

	A	B	C	D	E	F	G	H	I	J	K	L	M
2	6	5	4	3	2	1							
3													
4	7	8	9	10	11	12							
5													
6	18	17	16	15	14	13							
7													
8	19	20	21	22	23	24							
9													
10	30	29	28	27	26	25							
11													
12	31	32	33	34	35	36							
13													

A. Description of original monument and accessories and/or subsequent restoration:

ORIGINAL B.T.'s:

Cedar, 12", N88°E, 05 lks  
White Pine, 18", N47°W, 05 lks

Original Survey by James H. Mullett in 1848; All original evidence for this corner has been destroyed by county road improvements.

B. Description of corner evidence found and/or method applied in restoring or reestablishing corner:

Found Railroad Spike over 4" square concrete monument. The concrete monument was set in place of an old iron pin found by George B. Wilson, RLS 17607, as recorded in Book 1 of Land Corner Records on page 155. This corner falls in the centerline of Elmwood Road (East-West) and in line with the center of a County Road running North from this location. This corner position has been used for control in several surveys over the past 30 years, and is accepted as the best available evidence of the position of the original corner.

C. Description of monument for corner and accessories established to perpetuate locating the position of the corner:

Set 5/8" x 24" Iron Rod/3/4" dia. Aluminum cap stamped for corner, in Monument Box:

8" dia. Tamarack	N61°E	67.61 feet	
4" dia. White Ash	S38°E	70.17 feet	
9" dia. Tamarack	S33°W	73.07 feet	
5/8" x 24" Iron Rod/2" dia. Alum. cap marked	WITNESS MARKER	N57°W	76.43 feet
Steel Fence Post	S04°W	33.0 feet	

NOTE: All bearings are magnetic bearings; all distances are measured with steel tape; distances to trees are to nails in center of tree.

Signed by William Lenca Date Sept. 21, 1993  
Surveyor's Michigan License No. 26461