

LAND CORNER RECORDATION CERTIFICATE
Filing Requirement of Act 74, Mich. P.A. 1970

For corners in
Menominee

(County)

Located In:

Corner Code ~~##~~

1. Public Land Survey

T _____ R _____
T _____ R _____
T _____ R _____
T _____ R _____

2. Property Controlling
in Section

S _____ T 34N R 26W
S _____ T 34N R 26W

3. Miscellaneous

S _____ T 34N R 26W

Property in Sec.

S _____ T _____ R _____

Register of Deeds Stamp & File Number

4. Lot No. _____, Recorded Plat _____

5. Private Claims _____

8 April 04, 1995

6 April 12, 1995

5 April 04, 1995

I, Paul R. Bressette, in a field survey on 5 April 04, 1995, 19_____, do hereby certify that under requirements of P.A. 74, Michigan P.A. of 1970, the corner points mentioned in lines 1 and 2 above were in conformance with regulations and rules therefore as required in the current manual of survey instructions of the United States Department of the Interior, Bureau of Land Management or by a decree of a Court of Law and/or that the corner points mentioned in lines 3, 4 and 5 above were in conformance with the rules of the Michigan Board of Land Surveyors or by a Decree of a Court of Law; established, re-established, monumented, re-monumented, recovered, found as expressed below:

NOTE: Not more than 4 corners, all in the same town and range, may be recorded on this certificate.

A. Description of original monument and accessories and/or subsequent restoration:

- (5) North One-sixteenth corner of Section 1. Not set in original survey, no evidence of subsequent establishment.
- (6) Northeast One-sixteenth corner of Section 1. Not set in original survey, no evidence of subsequent establishment.
- (8) West One-sixteenth corner of Section 1. Not set in original survey, no evidence of subsequent establishment.

B. Description of corner evidence found and/or method applied in restoring or reestablishing corner:

- (5) Corner position established by single proportion between the North and Center Quarter corners of Section 1. Corner falls about 15 feet east of a dirt road. A small red pine bears S87W 81.15 feet distant for an extra witness.
- (6) Corner position established at the intersection of the north and east one-sixteenth lines of Section 1.
- (8) Corner position established mid-point and on-line between the West and Center Quarter corners of Section 1.


C. Description of monument for corner and accessories established to perpetuate locating the position of the corner:

(5) DNR monument
8" Sugar N12W 26.0'
8" Sugar S73E 39.25'
8" Ironwood N12W 103.25'
Cedar post West 0.7'

(6) DNR monument
8" Ash S83E 14.9'
6" Ash S33E 8.85'
7" Ash S87W
8" Ash N08E 10.8'

(8) DNR monument
4" W. Pine N75E 33.4'
6" Hemlock S39E 71.7'
12" R. Maple S43W 43.1'
5" R. Maple N02E 58.8'

	A	B	C	D	E	F	G	H	I	J	K	L	M
2	6	5	4	3	2	1							
3													
4	7	8	9	10	11	12							
5													
6	18	17	16	15	14	13							
7													
8	19	20	21	22	23	24							
9													
10	30	29	28	27	26	25							
11													
12	31	32	33	34	35	36							
13													

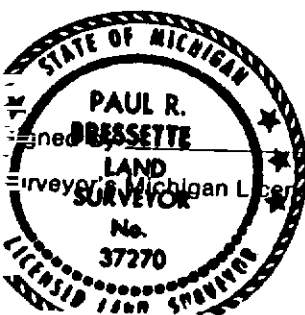

Paul R. Bressette Date 11-15-95
37270

For the Michigan Department of Natural Resources - Forest Management Division

FORM APPROVED BY MICHIGAN STATE BOARD OF LAND SURVEYORS, JAN. 28, 1971
REVISED MAY 14, 1975
REVISED JAN., 1983