

APR 06 1999

SECTION

LAND CORNER RECORDATION CERTIFICATE
Filing Requirement of Act 74, Mich. P.A. 1970

Approved by Menominee County
Land Survey Remuneration
Peer Group Under Act 345 Of

P.A. Of 1990 On 12/30, 1999

Mc Davis RLS
Chairman

RECEIVED FOR RECORD
99 JAN -6 AM 8:51
PAGE # 696
BARBARA MORRISON
REGISTER OF DEEDS
MENOMINEE, MI 49858

Register of Deeds Stamp & File Number

For corners in
MENOMINEE

(County)

Located In:

Corner Code #

- | | | |
|-------------------------|-------------------------------------|------|
| 1. Public Land Survey | T <u>35</u> N R <u>28</u> W | K-11 |
| | T <u> </u> R <u> </u> | |
| | T <u> </u> R <u> </u> | |
| | T <u> </u> R <u> </u> | |
| 2. Property Controlling | S <u> </u> T <u> </u> R <u> </u> | |
| in Section | S <u> </u> T <u> </u> R <u> </u> | |
| 3. Miscellaneous | S <u> </u> T <u> </u> R <u> </u> | |
| Property in Sec. | S <u> </u> T <u> </u> R <u> </u> | |

4. Lot No. , Recorded Plat
5. Private Claims

I, William Lenca, in a field survey on Sept. 16, 1998 do hereby state that under requirements of P.A. 74, Michigan P.A. of 1970, the corner points mentioned in lines 1 and 2 above were in conformance with regulations and rules therefore as required in the current manual of survey instructions of the United States Department of the Interior, Bureau of Land Management or by a decree of a Court of Law and /or that the corner points mentioned in lines 3, 4 and 5 above were in conformance with the rules of the Michigan Board of Land Surveyors or by a Decree of a Court of Law; established, re-established, monumented, recovered, found as expressed below:

NOTE: Not more than 2 corners, all in the same town and range, may be recorded on this certificate.


	A	B	C	D	E	F	G	H	I	J	K	L	M
1													
2	6		5		4		3		2		1		
3													
4	7		8		9		10		11		12		
5													
6	18		17		16		15		14		13		
7													
8	19		20		21		22		23		24		
9													
10	30		29		28		27		26		25		
11													
12	31		32		33		34		35		36		
13													

A. Description of original monument and accessories and/or subsequent restoration:

1852: Original Survey by Francis Coleman - B.T.'s - Y. Birch, 10" - N72°E - 34 lks.; Maple, 12" - S48°W - 59 lks. All original evidence for this corner has been destroyed by logging activities.

B. Description of corner evidence found and/or method applied in restoring or reestablishing corner:

We set this corner in line with ancient fence lines North and East, which have been accepted and used by local residence for many years. This location is accepted as the best available evidence of the position of the original corner.

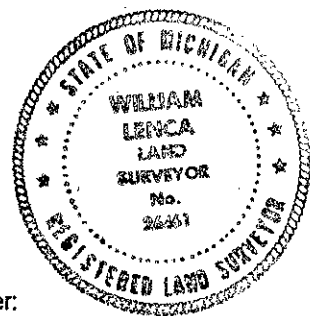

C. Description of monument for corner and accessories established to perpetuate locating the position of the corner:

Set 2" dia. Aluminum Pipe 30" long 3/4" dia. Alum. cap stamped for corner location:

6" dia. Balsam	S69°E	13.76 feet	"X" cut in upper and lower blazes
9" dia. Maple	S13°E	31.04 feet	"X" cut in upper and lower blazes
10" dia. White Pine	S72°W	36.11 feet	"X" cut in upper and lower blazes
12" dia. Maple	N02°W	39.82 feet	"X" cut in upper and lower blazes
Metal Survey Sign Post	East	18.5 feet	

NOTE: All bearings are magnetic bearings. All distances are measured with steel tape. Distances to trees are to nail in side of tree.

Dec. 29, 1998

Signed by William Lenca

Date

Surveyor's Michigan License No. 26461