

LAND CORNER RECORDATION CERTIFICATE
Filing Requirement of Act 74, Mich. P.A. 1970

For corners in

<u>Menominee</u> (County)	Located In:	Corner Code //
1. Public Land Survey	T R	
	T R	
	T R	
	T R	
2. Property Controlling in Section	S 27 T 36N R 28W	1, 3, 4
	S T R	
3. Miscellaneous	S T R	
Property in Sec.	S T R	

Register of Deeds Stamp & File Number

4. Lot No. _____, Recorded Plat _____
 5. Private Claims _____

I, Paul R. Bressette, in a field survey on November-December, 19 94, do hereby certify that under requirements of P.A. 74, Michigan P.A. of 1970, the corner points mentioned in lines 1 and 2 above were in conformance with regulations and rules therefore as required in the current manual of survey instructions of the United States Department of the Interior, Bureau of Land Management or by a decree of a Court of Law and/or that the corner points mentioned in lines 3, 4 and 5 above were in conformance with the rules of the Michigan Board of Land Surveyors or by a Decree of a Court of Law; established, re-established, monumented, re-monumented, recovered, found as expressed below:

NOTE: Not more than 4 corners, all in the same town and range, may be recorded on this certificate.

A. Description of original monument and accessories and/or subsequent restoration:

1. West One-sixteenth Corner common to Sections 22 and 27. Not set in original survey, no evidence of subsequent establishment.
3. North One-sixteenth Corner common to Sections 27 and 28. Not set in original survey, no evidence of subsequent establishment.
4. Northwest One-sixteenth Corner of Section 27. Not set in original survey, no evidence of subsequent establishment.


B. Description of corner evidence found and/or method applied in restoring or reestablishing corner:

1. Corner position established mid-point and on-line between the Northwest and North Quarter corners of Section 27.
3. Corner position established mid-point and on-line between the Northwest and West Quarter corners of Section 27.
4. Corner position established at the intersection of the north and west one-sixteenth lines of Section 27.

C. Description of monument for corner and accessories established to perpetuate locating the position of the corner:

- | | | |
|---------------------|--------------------------|----------------------|
| 1. DNR monument | 3. DNR monument | 4. DNR monument |
| 8" Maple N13E 31.0' | 10" Cherry N13E 74.7' | 7" Maple N31E 18.15' |
| 7" Maple S12E 48.5' | 13" Oak S77E 75.5' | 5" Maple S22E 6.7' |
| 20" Oak S68W 32.7' | 16" Cherry S48E 82.25' | 5" Maple S62W 28.1' |
| 6" Maple N65W 30.1' | 10" Rock Elm N22W 76.75' | 9" Maple N27W 33.6' |

	A	B	C	D	E	F	G	H	I	J	K	L	M
2	6	5	4	3	2								
3													
4	7	8	9	10	11	12							
5													
6	18	17	16	15	14	13							
7													
8	19	20	21	22	23	24							
9													
10	30	29	28	27	26	25							
11													
12	31	32	33	34	35	36							
13													

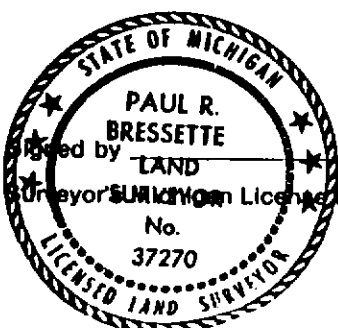

Paul R. Bressette Date 2-13-95
 Surveyor's License No. 37270