

LAND CORNER RECORDATION CERTIFICATE
Filing Requirement of Act 74, Mich. P.A. 1970

For corners in

MISSAUKEE

(County)

Located In:

Corner Code ##

1. Public Land Survey

T 21N R 6W

K-10, K-11.

T R

T R

T R

2. Property Controlling
in Section

S T R

S T R

3. Miscellaneous

S T R

Property in Sec.

S T R

Register of Deeds Stamp & File Number

4. Lot No. , Recorded Plat

5. Private Claims

I, CARL F. ROSER, in a field survey on JUNE 18, 19 91,
do hereby certify that under requirements of P.A. 74, Michigan P.A. of 1970, the corner points mentioned
in lines 1 and 2 above were in conformance with regulations and rules therefore as required in the
current manual of survey instructions of the United States Department of the Interior, Bureau of Land
Management or by a decree of a Court of Law and/or that the corner points mentioned in lines 3, 4 and 5
above were in conformance with the rules of the Michigan Board of Land Surveyors or by a Decree of a
Court of Law; established, re-established, monumented, re-monumented, recovered, found as
expressed below:

NOTE: Not more than 4 corners, all in the same town and range, may be recorded
on this certificate.

A. Description of original monument and accessories and/or subsequent restoration:

K-10

K-11

K-11 CONTINUED

K-11 CONTINUED

	A	B	C	D	E	F	G	H	I	J	K	L	M
2	6		5		4		3		2		1		
3													
4	7		8		9		10		11		12		
5													
6	16		17		18		19		20		21		
7													
8	19		20		21		22		23		24		
9													
10	30		29		28		27		26		25		
11													
12	31		32		33		34		35		36		
13													

B. Description of corner evidence found and/or method applied in restoring or reestablishing corner:

K-10

K-11

K-11 CONTINUED

K-11 CONTINUED

REESTAB'D E 1/4 COR OF SEC 26
MIDWAY & ON LINE BETWEEN SEC
COR'S 1/2 MILE TO N & S.

FD TOP 30" OF 4" SQ CED POST.
BADLY ROTTED BUT STILL IN SQ'D
SHAPE. LYING ON GRD W/IN ONE
FT OF PROPER SEC COR POSITION;
PER US BT (STP), W PINE 18"
N52 1/2°W, 37 LINKS (24.4').
FIELD NOTES OF MEX CO SURVEYOR
A.J. TEED, FIELD BK NO 125,
PGS 34 & 35, DATED SEPT 13,
1901 FOR JOHN W. MODDER'S
(MODDERSVILLE), HWY COMM (TNP);
SEC'S 25 & 26, T21N R6W, S4Y1

*FOUND W PINE NW OK WITH MARKS
ON STUMP AND Y PINE SW LYING
ON GROUND ROTTEN & ROTTEN
REMAINS OF STAKE. I SCALPED
& DUG FROM ABOVE-NOTED US BT
(STP) NW & AT 6" BELOW GRD
SURFACE, FOUND DEFINITE SHADOW
OF 3 1/2" DIA. STK POINT
BOTTOM, WHICH I WAS ABLE TO
FOLLOW TO A DEPTH OF 24" BELOW
GRD SURFACE. FD DEFINITE
"SOFT" STP HOLE

DEPRESSIONS (GRD COVER IS
HEAVY TO SWEET FERN) AT TEED'S
NBT'S, Y.P. 16, S79 1/2°E, 54
LINKS & Y.P. 18, S01°W, 24
LINKS; NO EVID OF HIS M.P. 24,
S63 3/4°W, 70 LINKS. THE 18"
M.P. US BT STP.NW, SHOWS MARKS
AS NOTED BY TEED. W/SUBSEQUENT
OLD AXE MARKS ON TWO OTHER
SIDES. TEED'S FIELD BOOKS ARE
NOW PART OF GOURDIE-FRASER
ASSOC. TRAVERSE CITY.

C. Description of monument for corner and accessories established to perpetuate locating the position of the corner:

K-10

K-11

K-11 CONTINUED


K-11 CONTINUED

SET DNR MON & CED POST.

SET DNR MON & CED POST.

8" W PINE N38°E 65.8'
6" R PINE S80°E 27.6'
5" W PINE S68°W 38.6'
3" R PINE N14°W 4.9'
CTR N-S WINDING
TRAIL WEST 20' ±

2" SPRUCE N50°E 29.3'
POWER POLE N85°E 35.64'
8" S PINE S72°E 7.4'
W PINE S40°W 22.4'
CTR LINE OF TRAIL S'LY
& NW'LY WEST 49.0'

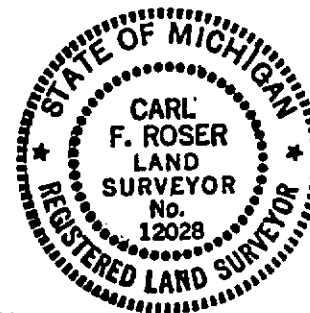

Signed by Carl F. Roser 12028

Date 12-02-92

Surveyor's Michigan License No.