

JAN 19 2000

LIBER 333 PAGE 450

SECTION

LAND CORNER RECORDATION CERTIFICATE
Filing Requirement of Act 74, Mich. P.A. 1970

#1363

For corners in

Missaukee County (County) Located In: Corner Code #

1. Public Land Survey T 21 N R 8 W H - 11

2. Property Controlling in Section S T R

3. Miscellaneous S T R

Property in Sec. S T R

MISSAUKEE COUNTY MICHIGAN
RECORDED DEC 09 1999 4:10 PM
Register of Deeds Stamp & File Number

4. Lot No. Recorded Plat

5. Private Claims

I, Daniel E. Schripsema, in a field survey on October 1, 1999 do hereby state that under requirements of P.A. 74, Michigan P.A. of 1970, the corner points mentioned in lines 1 and 2 above were in conformance with regulations and rules therefore as required in the current manual of survey instructions of the United States Department of the Interior, Bureau of Land Management or by a decree of a Court of Law and for that the corner points mentioned in lines 3, 4 and 5 above were in conformance with the rules of the Michigan Board of Land Surveyors or by a Decree of a Court of Law, established, re-established, monumented, recovered, found as expressed below:

NOTE: Not more than 2 corners, all in the same town and range, may be recorded on this certificate.

A. Description of original monument and accessories and/or subsequent restoration:

H - 11 - GLO - Set Post
14" Beech N. 76 1/2 E. 12
16" Sugar S. 10 3/4 E. 37
- County Surveyor notes May 7, 1894 - corner shown but no witness or comment

B. Description of corner evidence found and/or method applied in restoring or reestablishing corner:


Set 1/2" rerod on line with G-11 and I-11 opposite fence north projected south. This corner fits occupation to the West. This corner is accepted as the best available evidence of the position of the original corner.

C. Description of monument for corner and accessories established to perpetuate locating the position of the corner:

Set 1/2' Iron w/ Missaukee County Monument ± road centerline

WITNESSES

N18E 33.80' 20" Elm
N60E 55.65' Fence Post
N70W 86.87' 18" Maple
S40E 40.25' 5" Elm

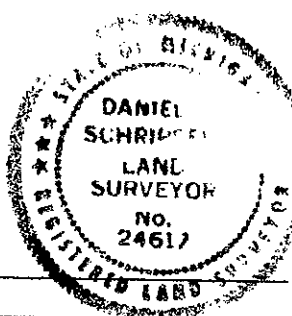

Peer Group Reviewed and Approved
Date: 12-9-99
J. Dean Geers, Missaukee Co. Representative

Signed by Daniel E. Schripsema
Surveyor's Michigan License No. 24617

Date 12-2-99