


LAND CORNER RECORDATION CERTIFICATE
Filing Requirement of Act 74, Mich. PA 1970

For Corners In: Missaukee (County) Located In Corner Code #
1. Public Land Survey T 22N R 5W K9
2. Property Controlling in Section S T R
3. Miscellaneous Property in Section S T R
4. Lot No: Recorded Plat:
5. Private Claims:

I, Craig W. McVean, in a field survey on Nov. 6, 2006 do hereby state that under requirements of PA 74, Michigan PA of 1970, the corner points mentioned in lines 1 and 2 above were in conformance with regulations and rules therefore as required in the current manual of survey instructions of the United States Department of the Interior, Bureau of Land Management or by a decree of a Court of Law and/or that the corner points mentioned in lines 3, 4 and 5 above were in conformance with the rules of the Michigan Board of Land Surveyors or by a Decree of a Court of Law; established, re-established, monumented, recovered, found as expressed below:

NOTE: Not more than 2 corners, all in the same town and range, may be recorded on this certificate.

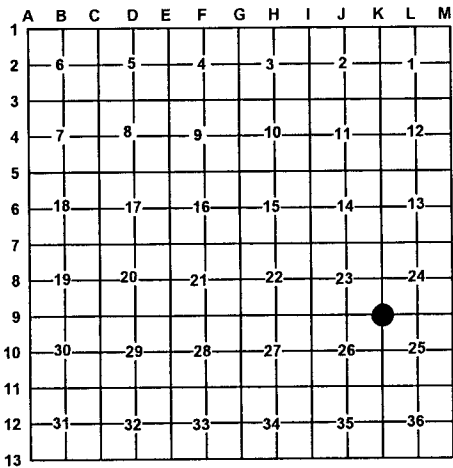

A. Description of original monument and accessories and/or subsequent restoration:

K9 - 1852 - GLO - A. Curtis. Set post corner.
7" W. Pine N9°W 13 L.
7" Spruce S16°E 32 L.
- 1916 - CSR - Book 21, p. 35
Corner fence post North 0.33
- 1967 - K. J. Ostling, DNR Surveyor, LCRC #488.
Set Con's, Dept. Mon. corner on line over 1/4 and Section corner East at proportionate measurement for longitude.
This checks measurement to Section corners North and South and to identifiable physical features South and East. Nothing found for evidence of a previous corner. Falls North and East of fence intersection, but fences found to be highly unreliable in this township.
8" J. Pine S10°E 32.6'
7: J. Pine S80°W 38.8'

B. Description of corner evidence found and/or method applied in restoring or re-establishing corner:

K9 - Corner common to Sections 23, 24, 25 & 26, T22N, R5W - Found 4" Aluminum Dept. of Conservation monument on 1" galvanized iron pipe and a scribed Cedar guard post, 2.0' above ground South one foot. No evidence of GLO or Country Surveyor witnesses. Not really sure how Ostling came up with this position we could find no evidence of a 1/4 corner 1/2 mile East or West. No evidence of section corner 1 mile North that would have existed when Ostling did his survey. His notes show that he tied a E-W fence 1 mile ± North at an old N-S'y Rd. and ditch crossing, that we found to follow the edge of an overgrown ditch. Measured N10°15'W 2703' to this Ostling Tie. From the DOC monument measured South 105'± 20' vs. 116' - GLO to edge of open saw grass marsh. Measured East 134'±10' vs. 347' to edge of saw grass marsh. By proportion to GLO to Section corners 1 mile E & W the corner should 11.6' farther West. Could see no good reason to adjust DOC monument. Dept. of Conservation monument accepted as best available evidence of the position of the original corner.

C. Description of monument for corner and accessories established to perpetuate locating the position of the corner:

K9 - A 4" aluminum stamped Dept. of Conservation (DNR) cap on 1" galv. iron pipe
S77°W 39.05' to set N & T in S. side 12" J. Pine (KJO)
S13°E 32.97' to set N & T in W. side 14" J. Pine (KJO)
East 23.86' to set N & T in S. side 5" J. Pine scribed 'XBT'
N61°E 53.29' to set N & T in NW side 20" triple Oak scribed 'XBT'
North 48.11' to set N & T in E. side 7" J. Pine scribed 'XBT'
Set Blue Carsonite Post 1' North



Signed by: [Signature of Craig W. McVean] Date: 12/18/2007
Surveyor's Michigan License No.: 39088