

LAND CORNER RECORDATION CERTIFICATE  
Filing Requirement of Act 74, Mich. P.A. 1970

For corners in  
MISSAUKEE  
(County)

Located In:

Corner Code =#

1. Public Land Survey

T 23N R 6W M-1, M-2  
T      R      M-3

2. Property Controlling  
in Section

S 1 T      R      7  
S      T      R     

3. Miscellaneous  
Property in Sec.

S      T      R       
S      T      R     

Register of Deeds Stamp & File Number

4. Lot No.     , Recorded Plat     

5. Private Claims     


I, CARL F. ROSER, in a field survey on AUGUST 29, 19 91,  
do hereby certify that under requirements of P.A. 74, Michigan P.A. of 1970, the corner points mentioned  
in lines 1 and 2 above were in conformance with regulations and rules therefore as required in the  
current manual of survey instructions of the United States Department of the Interior, Bureau of Land  
Management or by a decree of a Court of Law and/or that the corner points mentioned in lines 3, 4 and 5  
above were in conformance with the rules of the Michigan Board of Land Surveyors or by a Decree of a  
Court of Law; established, re-established, monumented, re-monumented, recovered, found as  
expressed below:

NOTE: Not more than 4 corners, all in the same town and range, may be recorded  
on this certificate.

A. Description of original monument and accessories and/or subsequent restoration:

M-1 M-2 M-3

	A	B	C	D	E	F	G	H	I	J	K	L	M
2	6	5	4	3	2	1							
3													
4	7	8	9	10	11	12							
5													
6	18	17	16	15	14	13							
7													
8	19	20	21	22	23	24							
9													
10	30	29	28	27	26	25							
11													
12	31	32	33	34	35	36							
13													

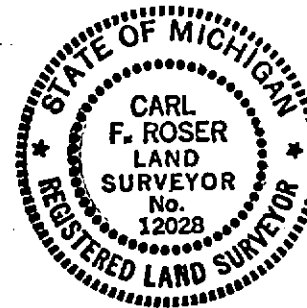

B. Description of corner evidence found and/or method applied in restoring or reestablishing corner:

M-1	M-2	M-3	7
ACCEPTED FD 1/2" REROD FOR NE COR SEC 1. THIS MON PLACED BY RLS GENE OSTLING IN 1968 AND USED BY RLS ROBERT MITCHELL IN 1985. MON IS IN CTR N-S BIT RD. CTR OLD E-W RR GRADE IS 49'S. MON IS IN LINE ± 3' W/FD OLD FN REMAINS TO EAST.	REESTABLISHED THE E 1/4 COR SEC 1 ON LINE & PRORATED DISTANCE TO GLO SURVEY BETWEEN SE & NE COR'S OF SEC 1. CTR N-S BIT RD IS 1'W.	ACCEPTED FD 1/2" REROD W/RLS CAP FOR SE COR SEC 1. R. MITCHELL ESTABLISHED THIS COR BY PROPORTIONATE MEASUREMENT TO COR'S 1 MI N & 1 MI S AND IN THE CTR OF N-S RD.	ESTABLISHED THE NW COR OF SW 1/4 OF FRL NW 1/4 OF SEC 6 (T23N-R5W), ON LINE & PROP. NEA TO GLO RESURVEY (RUN-OUT SEC) BTWN NW SEC COR & N 1/4 COR OF SAID SEC 6. CTR N-S BIT RD IS 2'W.

C. Description of monument for corner and accessories established to perpetuate locating the position of the corner:

M-1	M-2	M-3	7
FD 1/2" REROD. 5" MAPLE N45°W 63.0' POWER POLE N60°E 35.88' NW COR WOOD FRAME CABIN S80°E 70.7' 3" BALSAM S57°W 45.6' SET CED POST W/LOC TAG BY FD 1/2" REROD. WEST 33.0'	DROVE 5/8" X 34" REROD W/RLS CAP. POWER POLE S15°W 124.68' 12" TAMARACK S60°W 97.36' 11" TAMARACK WEST 96.6' 13" TAMARACK N45°W 123.9' SET CED POST W/ LOC TAG. WEST 33.0'	FD 1/2" REROD W/RLS CAP. *POWER POLE S62°W 34.85' *17" POPLAR S45°E 68.22' E 1/4 SEC 1.5/8" REROD W/RLS CAP. N01°07'19"W 2649.76' E 1/4 SEC 12 S00°01'07"E 2649.41' SET CED POST W/ LOC TAG. WEST 33' *RLS ROBERT MITCHELL MIT.	DROVE 5/8" X 34" REROD W/RLS CAP. 9" TAMARACK N65°W 52.8' 3" BALSAM N60°E 46.4' POWER POLE S25°E 63.27' 5" TAMARACK S70°W 40.7' SET CED POST W/ LOC TAG. EAST 33.0'

Signed by Carl F. Roser 12028 8-13-92 Date

Surveyor's Michigan License No.