

For corners in

Missaukee County
(County)

Located in:

Corner Code #

1. Public Land Survey

T 23N R 6W

M-4

2. Property Controlling in Section

§
§

T	R
T	R

3. Miscellaneous Property in Sec.

SS

T	R
T	R

4. Lot No. _____, Recorded Plat

5. Private Claims

I, Daniel E. Schripsema, in a field survey on October 1, 1997 do hereby state that under requirements of P.A. 74, Michigan P.A. of 1970, the corner points mentioned in lines 1 and 2 above were in conformance with regulations and rules therefore as required in the current manual of survey instructions of the United States Department of the Interior, Bureau of Land Management or by a decree of a Court of Law and /or that the corner points mentioned in lines 3, 4 and 5 above were in conformance with the rules of the Michigan Board of Land Surveyors or by a Decree of a Court of Law; established, re-established, monumented, recovered, found as expressed below:

NOTE: Not more than 2 corners, all in the same town and range, may be recorded on this certificate

A. Description of original monument and accessories and/or subsequent restoration:

M-4) 1839 GLO survey set quarter post section 12; 10" diameter Black Ash named corner
1985 Robert F. Mitchell LCRC, #700; Set ½" rerod w/ cap
N39E 2" Iron pipe @ C.F.P. 65.50', S83E 6" Elm 52.33', S34E 4" Elm 79.30'
1992 Carl F. Roser LCRC, #866; Fd. ½" rerod w/ cap
Fd. 2" Pipe N40E 65.4', 13" W. Ash N55E 80.84', 3" Elm S60E 58.02', 7" Elm S30E 79.28'
Set Cedar Post w/ tag East 33.0'

B. Description of corner evidence found and/or method applied in restoring or reestablishing corner:

M-4) Corner common to Section 12, T23N, R6W, and Section 7, T23N, R5W. Found ½" rerod / cap of record. Corner falls 0.5' West of centerline of N&S road and 50' South of fence line East.

This corner is accepted as a careful and faithful reestablishment of the position of the original corner.

C. Description of monument for corner and accessories established to perpetuate locating the position of the corner:

M-4) Set Missaukee County Monument on existing 1/2" rerod.


S34E	79.34'	7" elm	*
S63E	57.85'	4" elm	
East	33.27'	DNR cedar post	
N40E	65.47'	2" pipe	
N51E	80.84'	14" Ash	*
S21W	66.81'	5" apple	

Peer Group Reviewed and Approved

Date: 12-18-97
J. Dean Geers, Missaukee Co. Representative

Signed by John E. Schryer
Surveyor's Michigan License No. 24617

Date 12-2-97

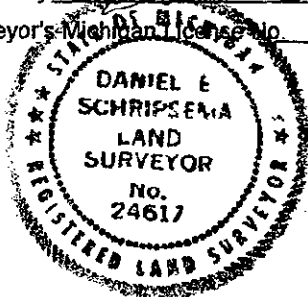

SURVEY & REMONUMENTATION

JAN 16 1998

SECTION

FORM APPROVED BY MICHIGAN STATE BOARD OF PROFESSIONAL SURVEYORS, JAN. 26, 1971
 ON REVISED MAY 14, 1975
 REVISED JAN., 1983
 REVISED OCT., 1985