


STATE OF MICHIGAN
DEPARTMENT
OF
NATURAL RESOURCES

LAND CORNER RECORD

MISSAUKIE COUNTY
T 24 N R 5 W

DESCRIPTION OF CORNER N 1/4 corner, Section 6
CORNER MONUMENT Set DNR Monument
DATE MONUMENT PLACED AND WITNESSED 10-20-71
WITNESSES TO CORNER..... 12" Oak S 4 W 46.4'

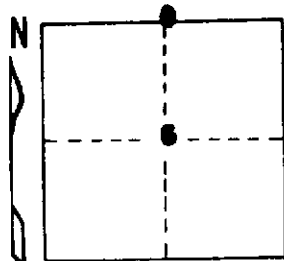


12" Oak N 55 W 36.8'
14" Oak N 7 W 54.8'
AND
Ctr. E-W Trail Rd. Due S. 4'
Set Cedar Post w/location tag Due N 18.8'

CIRCLE CORNER REGISTERED

DESCRIPTION IN DETAIL AS TO HOW CORNER WAS LOCATED AND IDENTIFIED OR RESTORED.

Corner reestablished per standard S.L.M. instructions.

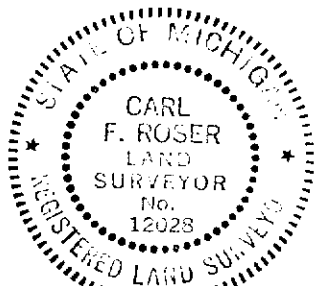

SURVEYOR'S SEAL

SIGNED Carl F. Rose DATE 11-4-71
REGISTERED LAND SURVEYOR 12028

DISTRIBUTION:

County Courthouse
Area Forester (Regions I & II)
District or Region Surveyor
Forestry Div., Lansing

R 4047
Rev. 10/68