

STATE OF MICHIGAN
DEPARTMENT
OF
NATURAL RESOURCES

LAND CORNER RECORD


✓

MISSAUKIE COUNTY
T 24 N R 6 W

DESCRIPTION OF CORNER NE Corner of Section 9

CORNER MONUMENT Re-Wit. Exist. Dept. Mon.


DATE MONUMENT PLACED AND WITNESSED 7-28-71

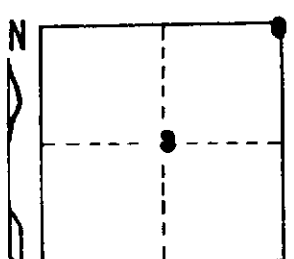	WITNESSES TO CORNER.....	8" R. Pine	N 8 E	24.1'
		12" R. Pine	N 28 W	59.3'
		12" R. Pine	N 51 W	74.8'
		14" W. Pine	S 71 W	48.5'
		AND New Fence Cor. Rand. S.	Due S Due E	8' 8'

CIRCLE CORNER REGISTERED

DESCRIPTION IN DETAIL AS TO HOW CORNER WAS LOCATED AND IDENTIFIED OR RESTORED.

Exist. DNR Mon. previously set to perpetuate Schaeff's corner which was a restored U.S. Corner by U.S.B.T. stumps, July 1940.

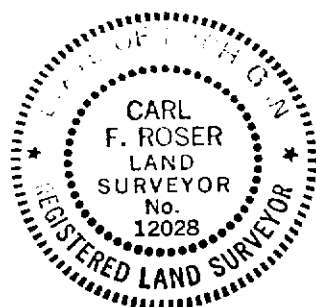

SURVEYOR'S SEAL

SIGNED Carl F. Roser DATE 8-4-71
REGISTERED LAND SURVEYOR **12028**

DISTRIBUTION:

County Courthouse
Area Forester (Regions I & II)
District or Region Surveyor
Forestry Div., Lansing

R 4047
Rev. 10/68