

✓

STATE OF MICHIGAN
DEPARTMENT
OF
NATURAL RESOURCES

LAND CORNER RECORD


MISSAUXEE COUNTY
T 24 N R 6 W

DESCRIPTION OF CORNER S 1/16 corner on N-S 1/4 line, Sec. 2

CORNER MONUMENT Set 1"x36" pipe & Cedar post with location tag

DATE MONUMENT PLACED AND WITNESSED 9-22-71

WITNESSES TO CORNER..... 1" Apple (4-cluster) Due So. 40.0'

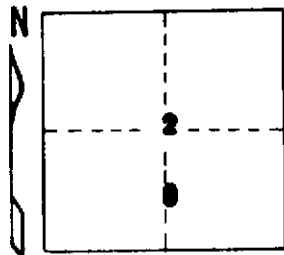

18" B. Cherry N 55 E 20.5'

8"x10"x24" Rock set on end N 80 W 18.0'


AND

Ctr. N-S dirt rd. Due W 172' ±

CIRCLE CORNER REGISTERED

DESCRIPTION IN DETAIL AS TO HOW CORNER WAS LOCATED AND IDENTIFIED OR RESTORED.

Corner established per B.L.M. instructions.

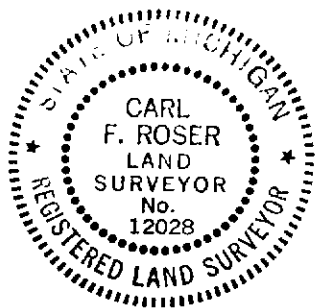

SURVEYOR'S SEAL

SIGNED Carl F. Roser DATE 9-29-71
REGISTERED LAND SURVEYOR 12028

DISTRIBUTION:

County Courthouse
Area Forester (Regions I & II)
District or Region Surveyor
Forestry Div., Lansing

R 4047
Rev. 10/68