

STATE OF MICHIGAN
DEPARTMENT
OF
NATURAL RESOURCES
LAND CORNER RECORD


MISSAUKIE COUNTY
T 24 N R 6 W

DESCRIPTION OF CORNER NE corner, Section 2

CORNER MONUMENT Re-witness Exist. Dept. Mon.

DATE MONUMENT PLACED AND WITNESSED 7-28-71

WITNESSES TO CORNER..... 8" Cedar S 66 W 19.5'

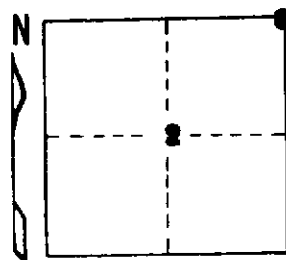

8" Cedar N 21 W 11.0'


8" Tamarack N 24 E 21.8'

AND 8" Cedar S 29 E 15.0'

CIRCLE CORNER REGISTERED

DESCRIPTION IN DETAIL AS TO HOW CORNER WAS LOCATED AND IDENTIFIED OR RESTORED.

Existing DNR monument previously set to perpetuate Schaaf's corner which was a restored U.S. corner by U.S.B.T. stumps, June 1940.

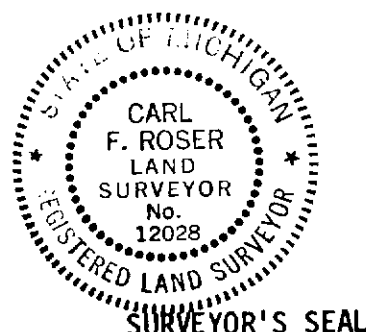

SURVEYOR'S SEAL

SIGNED Carl F. Roser DATE 8-4-71
REGISTERED LAND SURVEYOR 12028

DISTRIBUTION:

County Courthouse
Area Forester (Regions I & II)
District or Region Surveyor
Forestry Div., Lansing

R 4047
Rev. 10/68