

# SURVEY & REMONUMENTATION

Montmorency County Remonumentation

Liber 00012 Page 0444

JAN 22 2001

## LAND CORNER RECORDATION CERTIFICATE Filing Requirement of Act 74, Mich. P.A. 1970

### SECTION

For corners in

MONTMORENCY  
(County)

Located in:  
BRILEY TWP.

Corner Code #

1. Public Land Survey

T 30N	R 2E	E-4
T	R	
T	R	
T	R	
S	T	R
S	T	R
S	T	R
S	T	R

2. Property Controlling  
in Section

3. Miscellaneous  
Property in Sec.

4. Lot No. \_\_\_\_\_, Recorded Plat \_\_\_\_\_

5. Private Claims \_\_\_\_\_

STATE OF MICHIGAN  
MONTMORENCY COUNTY  
Recorded & Filed

12-05-2000 10:06:57


TERESA WALKER  
REGISTER OF DEEDS

Register of Deeds Stamp & File Number

I, DONALD E MARLATT, in a field survey on MAY 2000 do hereby state that under requirements of P.A. 74, Michigan P.A. of 1970, the corner points mentioned in lines 1 and 2 above were in conformance with regulations and rules therefore as required in the current manual of survey instructions of the United States Department of the Interior, Bureau of Land Management or by a decree of a Court of Law and for that the corner points mentioned in lines 3, 4 and 5 above were in conformance with the rules of the Michigan Board of Land Surveyors or by a Decree of a Court of Law, established, re-established, monumented, recovered, found as expressed below:

NOTE: Not more than 2 corners, all in the same town and range, may be recorded on this certificate.

(OUT OF PLACE) CIRCA 1940 TYPICAL CORNER MONUMENT AND  
REFERENCE MONUMENTS BY FRANK SMITH P.S. #754

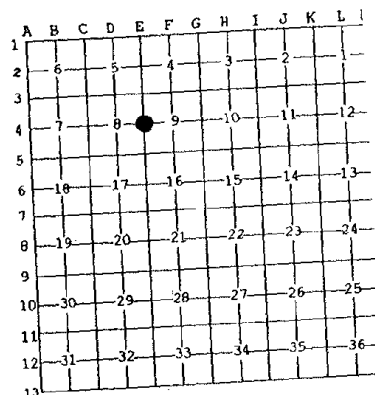

A. Description of original monument and accessories and/or subsequent restoration:

E-4 1/4 CORNER COMMON TO SECTIONS 8 & 9.  
G.L.O. COR. WAS SET BY LEWIS CLASON IN APRIL 1840. Hd MAPLE 8" N76°E 26 L., Hd MAPLE 6" S68°W  
G.G. SLATTERY P.E. MAY 1967, MSHD SURVEY CREW CHIEF FOUND 1/2" PIN IN CONC., BURIED 0.8' AND  
RAISED WITH 5/8" IRON PIN FLUSH WITH BIT. SURFACE. 1' NORTH OF M-32 E & W & 4' EAST OF ROAD  
C/L SOUTH. N50°W 56.49' P. POLE, N 9°W 24.49' 19" MAPLE, N35°E 26.19' 27" MAPLE, N45°E 50.07'  
CONC. MONUMENT. (COUNTY NOTES (NO DATE) N45°E 50' MONUMENT, S45°W 50' MONUMENT).  
D.E. MARLATT P.S. #18660 FILED ACT 74 DATED 10-30-74 & RECORDED IN L. 1, P. 142. FOUND EXIST-  
ING MONUMENT. N50°W 56.49' P. POLE, N 9°W 24.49' 19" MAPLE, N35°E 26.19' 27" MAPLE.  
D.E. MARLATT P.S. FILED ACT 132 DATED 9/12/77 AND RECORDED IN L. 2, P. 382. FOUND 5/8" ROD  
N50°W 56.49' P. POLE, N 9°W 24.49' 20" MAPLE, N35°E 26.19' 27" MAPLE.  
D.E. MARLATT P.S. FILED ACT 132 DATED 11/15/96 & RECORDED IN L. 10004, P. 441. FOUND 5/8" ROD  
IN MON. BOX. N50°W 56.49' P. POLE, N 9°W 24.49' 25" MAPLE, N35°E 26.19' 31" MAPLE, N45°E  
50.07' MONUMENT, S20°E 51.3' STOP SIGN. 1' NORTH OF C/L.  
CLIFF LINDGREN P.S. #14098 FILED ACT 74 DATED 2/14/96 RECORDED IN L. 1, P. 520. FOUND 5/8" PIN  
IN MON. BOX. FOUND MSHD 1967 SURVEY WIT. & ACT 74 L. 1, P. 142 WIT. REWIT. N30°E 25.33'  
36" MAPLE, N 8°W 24.37' 28" MAPLE, N43°W 56.49' P. POLE, S45°W 62.19' TOP OF WOOD POST,  
36" MAPLE, N 8°W 24.37' 28" MAPLE, N43°W 56.49' P. POLE, S45°W 62.19' TOP OF WOOD POST,

B. Description of cor. evidence found and/or method applied in restoring or reestablishing cor.

E-4 1/4 CORNER COMMON TO SECTIONS 8 & 9.  
FOUND 5/8" PIN IN MONUMENT BOX.  
N39°W 56.6' P. POLE R. N50°E 50.07' CONC. MONUMENT (TIPPED) R. (F.S. TYP.)  
N 9°W 24.45' 29" MAPLE R. S70°W 104.25' 14" N. PINE

C. Description of monument for corner and accessories established to perpetuate locating the position of the corner:

E-4 1/4 CORNER COMMON TO SECTIONS 8 & 9  
PLACED REMON. CAP ON 5/8" PIN IN MONUMENT BOX  
N39°W 56.60' P. POLE  
N 9°W 24.45' 29" MAPLE  
N50°E 50.07' CONC. MONUMENT (TIPPED)  
S70°W 104.25' 14" NORWAY PINE

WITNESSES MARKED WITH 40 PENNY SPIKES AND P.S. TAGS #18660  
APPROVED BY PEER GROUP ON JULY 18, 2000 AS THE BEST AVAILABLE EVIDENCE OF THE OF THE  
POSITION OF THE ORIGINAL CORNER.

Signed by Donald E Marlatt

Surveyor's Michigan License No. 18660

Date 12/4/2000