

For corners in

Located In:

Corner Code ~~##~~

- | | | | | |
|---------------------------------------|-------------|--------------|-------------|----------|
| 1. Public Land Survey | | T | R | |
| | | T | R | |
| | | T | R | |
| | | T | R | |
| 2. Property Controlling
in Section | S <u>20</u> | T <u>30N</u> | R <u>3E</u> | <u>9</u> |
| | S | T | R | |
| 3. Miscellaneous
Property in Sec. | S | T | R | |
| | S | T | R | |

Register of Deeds Stamp & File Number

4. Lot No. _____, Recorded Plat _____
5. Private Claims _____

I, Carl R. Johnson, in a field survey on April 8, 1991, 19 , do hereby certify that under requirements of P.A. 74, Michigan P.A. of 1970, the corner points mentioned in lines 1 and 2 above were in conformance with regulations and rules therefore as required in the current manual of survey instructions of the United States Department of the Interior, Bureau of Land Management or by a decree of a Court of Law and/or that the corner points mentioned in lines 3, 4 and 5 above were in conformance with the rules of the Michigan Board of Land Surveyors or by a Decree of a Court of Law; established, re-established, monumented, re-monumented, recovered, found as expressed below:

NOTE: Not more than 4 corners, all in the same town and range, may be recorded on this certificate.

A. Description of original monument and accessories and/or subsequent restoration:

B. Description of corner evidence found and/or method applied in restoring or reestablishing corner:


9 - Corner established by standard survey procedure for subdivision of a Section.

C. Description of monument for corner and accessories established to perpetuate locating the position of the corner:

9 - E 1/8 Cor. on E-W 1/4 line.

Set 5/8" bar w/cap.

7" Balsam	N70°E	14.3'
7" Balsam	S35°E	10.3'
16" Cedar Stump	S34°W	12.7'
4" Balsam	N56°W	13.6'

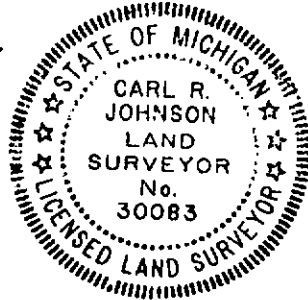

Signed by Paul K. Loh

Date 1-6-92

Surveyor's Michigan License No. 30083