

LAND CORNER RECORDATION CERTIFICATE
Filing Requirement of Act 74, Mich. P.A. 1970

For corners in
MONTMORENCY
(County)

Located In:

Corner Code ##

1. Public Land Survey

T 31N R 4E

8-7

T R

T R

T R

T R

2. Property Controlling
in Section

S 18

T R

7

S 18

T R

5

3. Miscellaneous
Property in Sec.

S T

R

S T

R

Register of Deeds Stamp & File Number

4. Lot No. , Recorded Plat

5. Private Claims

I, Carl R. Johnson, in a field survey on April 2, 19 92,
do hereby certify that under requirements of P.A. 74, Michigan P.A. of 1970, the corner points mentioned
in lines 1 and 2 above were in conformance with regulations and rules therefore as required in the
current manual of survey instructions of the United States Department of the Interior, Bureau of Land
Management or by a decree of a Court of Law and/or that the corner points mentioned in lines 3, 4 and 5
above were in conformance with the rules of the Michigan Board of Land Surveyors or by a Decree of a
Court of Law; established, re-established, monumented, re-monumented, recovered, found as
expressed below:

NOTE: Not more than 4 corners, all in the same town and range, may be recorded
on this certificate.

A. Description of original monument and accessories and/or subsequent restoration:
8-7 7 5

	A	B	C	D	E	F	G	H	I	J	K	L	M
2	6	5	4	3	2	1							
3													
4	7	8	9	10	11	12							
5													
6	13	14	15	16	17	18							
7													
8	19	20	21	22	23	24							
9													
10	25	26	27	28	29	30							
11													
12	31	32	33	34	35	36							
13													

B. Description of corner evidence found and/or method applied in restoring or reestablishing corner:

8-7

7

5

Set by single proportionate
measurement between found
section corners. No evidence
of original or subsequent
survey.

Set by standard survey
procedure for subdivision of a
section.

Set by standard survey
procedure for subdivision of a
section.

C. Description of monument for corner and accessories established to perpetuate locating the position of the corner:

8-7

7

5

South 1/4 corner section 18
Set DNR Monument


Jack Pine 5" N68E 8.4 ft
Jack Pine 5" N35E 16.0 ft
Jack Pine 5" N66W 14.3 ft
Jack Pine 5" S17W 15.8 ft

N 1/8 cor. between 18/17
Set 5/8" Rerod w/cap

Oak 5" N64E 27.22 ft
Oak 6" S42E 37.13 ft
Oak 4" S62W 26.55 ft
Oak 6" N33W 5.40 ft
Fence cor. post S40W 2.72 ft

N 1/8 cor. on N-S 1/4 line sec
18
Set 5/8" Rerod w/cap

Oak 8" N63E 9.45 ft
Jack Pine 8" N18E 27.85 ft
Jack Pine 3" N60W 14.27 ft
Jack Pine 5" S36W 20.5 ft

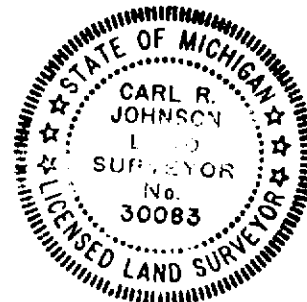

Signed by Carl R. Johnson

Date 7/7/92

Surveyor's Michigan License No. 30083