

MAR 19 1998

**NEWAYGO COUNTY
REGISTER OF DEEDS
LINDA M. BROWN**

1997 Newaygo County Remonumentation Project

SECTION

**LAND CORNER RECORDATION CERTIFICATE
FILING REQUIREMENT of Act 74, Mich. P.A. 1970**

'98 MAR 6 PM 12 35

Linda M. Brown

For corners in <u>Newaygo</u> (County)	Located in:	Corner Code #
1. Public Land Survey	T <u>13N</u> R <u>14W</u>	<u>E-5</u>
	T <u> </u> R <u> </u>	<u> </u>
	T <u> </u> R <u> </u>	<u> </u>
	T <u> </u> R <u> </u>	<u> </u>
2. Property Controlling in Section	S <u> </u> T <u> </u> R <u> </u>	<u> </u>
	S <u> </u> T <u> </u> R <u> </u>	<u> </u>
3. Miscellaneous Property in Sec.	S <u> </u> T <u> </u> R <u> </u>	<u> </u>
	S <u> </u> T <u> </u> R <u> </u>	<u> </u>
4. Lot No. <u> </u> , Recorded Plat <u> </u>		
5. Private Claims <u> </u>		

VOL. 2

88

Register of Deeds Stamp & File Number

	A	B	C	D	E	F	G	H	I	J	K	L	M
1													
2	6		5		4		3		2		1		
3													
4	7		8		9		10		11		12		
5													
6	18		17		16		15		14		13		
7													
8	19		20		21		22		23		24		
9													
10	30		29		28		27		26		25		
11													
12	31		32		33		34		35		36		
13													

I, Norman L. Ochs, in a field survey on August 23, 1997, do hereby certify that under requirements of P. A. 74, Michigan P.A. of 1970, the corner points mentioned in lines 1 and 2 above were in conformance with regulations and rules therefore as required in the current manual of survey instructions of the United States Department of the Interior, Bureau of Land Management or by a decree of a Court of Law and/or that the corner points mentioned in lines 3, 4 and 5 above were in conformance with the rules of the Michigan Board of Land Surveyors or by a Decree of a Court of Law; established, re-established, monumented, re-monumented, recovered, found as expressed below:

Note: Not more than 4 corners, all in the same town and range, may be recorded on this certificate.

Southeast Corner, Section 8, Dayton Township, Newaygo County, Michigan.

A. DESCRIPTION OF ORIGINAL MONUMENT AND ACCESSORIES AND/OR SUBSEQUENT RESTORATION:

G.L.O. John Mullett 1838
8" Beech S46°E 33 Links (21.78') #1
8" Beech S39°W 17 Links (11.22') #2

William Fries, Jr. R.L.S. #30389
LCRC #1027 August 9, 1990
Found 6" X 10" Bluish Conical Stone. Replaced stone with Iron and cap #30389 in intersection of roads North and South, East and West. Newaygo County Road Commission assisted with excavation at intersection.
Nail and tag in ground N30°E 91.87' #6
Nail and tag in ground N30°E 122.10' #7
Southeast Corner House Foundation N55°E 155.72' #8
20" Maple N64°E 154.62' Nail in root. #9

Newaygo County Road Commission Sheet
Blue Stone
8" Apple Southeast 72.7' #3
20" Poplar Northeast 65.9' #4
24" Poplar Northeast 38.6' #5

Stanley Kass R.L.S. #34972
LCRC #1183 February 23, 1993
Corner apparently removed during road construction. Reset corner by following witnesses. Set 1/2" X 24" Iron rod capped "Westshore 34972"
Nail in ground N30°E 91.87' #6
Southeast Corner House Foundation N55°E 155.72' #8
20" Maple N64°E 154.62' Nail and tag in root. #9
6" Elm N21°W 106.10' #10

B. DESCRIPTION OF CORNER EVIDENCE FOUND AND/OR METHOD APPLIED IN RESTORING OR REESTABLISHING CORNER:

Found 1/2" X 24" Rod and cap "Westshore #34972" at surface of bituminous road and found 1/2" X 18" Rod and cap #30389 below surface. The centerline of the gravel road going North and South is 3 feet West and in the centerline of gravel road going East and West. The condition of the recorded witnesses are: #1 thru #7 gone, #8 thru #10 good condition.

C. DESCRIPTION OF MONUMENT FOR CORNER AND ACCESSORIES ESTABLISHED TO PERPETUATE LOCATING THE POSITION OF THE CORNER:

Removed both Rod and caps and set a 4" diameter Harrison cast iron monument 20" long marked "County Surveyor" as a substantial marker for the section corner and is accepted as a careful and faithful reestablishment of the original corner.

Southeast Corner House Foundation N61°E 155.91' #8
24" Maple N70°E 154.69' Found spike in root. #9
10" Elm N15°W 106.12' Found spike in West side of tree. #10
18" Culvert S45°E 47.1' to centerline East end.


Signed by Norman L. Ochs
Norman L. Ochs

Date September 8, 1997

Surveyor's Michigan License No. 22439

Form approved by Michigan State Board of Land Surveyors, Jan 20, 1997
Revised May 14, 1995
Revised Jan, 1983

Approved by Peer Review Group on October 14, 1997
Norman L. Ochs, County Representative.

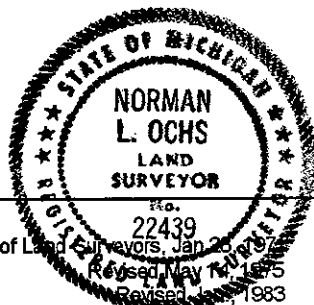

N.L.O.