

MAY 28 1997

COMMISSION

1996 Newaygo County Remonumentation Project

LAND CORNER RECORDATION CERTIFICATE
FILING REQUIREMENT of Act 74, Mich. P.A. 1970

NEWAYGO COUNTY
REGISTER OF DEEDS
LINDA M. BROWN

'97 FEB 12 PM 4 45

Linda M. Brown

For corners in <u>Newaygo</u> (County)	Located in:	Corner Code #
1. Public Land Survey	T <u>16N</u> R <u>14W</u>	<u>G-11</u>
	T <u> </u> R <u> </u>	<u> </u>
	T <u> </u> R <u> </u>	<u> </u>
	T <u> </u> R <u> </u>	<u> </u>
2. Property Controlling in Section	S <u> </u> T <u> </u> R <u> </u>	<u> </u>
	S <u> </u> T <u> </u> R <u> </u>	<u> </u>
3. Miscellaneous Property in Sec.	S <u> </u> T <u> </u> R <u> </u>	<u> </u>
	S <u> </u> T <u> </u> R <u> </u>	<u> </u>
4. Lot No. <u> </u> , Recorded Plat <u> </u>		
5. Private Claims <u> </u>		

VOL. 2 PAGE 46

Register of Deeds Stamp & File Number

	A	B	C	D	E	F	G	H	I	J	K	L	M
2	0	5	4	3	2	1	0	9	8	7	6	5	4
3	1	6	5	4	3	2	1	0	9	8	7	6	5
4	2	7	6	5	4	3	2	1	0	9	8	7	6
5	3	8	7	6	5	4	3	2	1	0	9	8	7
6	4	9	8	7	6	5	4	3	2	1	0	9	8
7	5	0	9	8	7	6	5	4	3	2	1	0	9
8	6	1	0	9	8	7	6	5	4	3	2	1	0
9	7	2	1	0	9	8	7	6	5	4	3	2	1
10	8	3	2	1	0	9	8	7	6	5	4	3	2
11	9	4	3	2	1	0	9	8	7	6	5	4	3
12	0	5	4	3	2	1	0	9	8	7	6	5	4
13	1	6	5	4	3	2	1	0	9	8	7	6	5

I, Norman L. Ochs, in a field survey on September 3, 1996, do hereby certify that under requirements of P. A. 74, Michigan P.A. of 1970, the corner points mentioned in lines 1 and 2 above were in conformance with regulations and rules therefore as required in the current manual of survey instructions of the United States Department of the Interior, Bureau of Land Management or by a decree of a Court of Law and/or that the corner points mentioned in lines 3, 4 and 5 above were in conformance with the rules of the Michigan Board of Land Surveyors or by a Decree of a Court of Law; established, re-established, monumented, re-monumented, recovered, found as expressed below:

Note: Not more than 4 corners, all in the same town and range, may be recorded on this certificate.

Northwest Corner, Section 34, Troy Township, Newaygo County, Michigan

A. DESCRIPTION OF ORIGINAL MONUMENT AND ACCESSORIES AND/OR SUBSEQUENT RESTORATION:

G.L.O. Thomas Whelpley 1856 Resurvey
12" Cedar N88°W 18 Links (11.88') #1
12" Black Ash S77°E 7 Links (4.62') #2

United States Forest Service 1936
LCRC #207 Found Iron Post
5" Cedar Post South 33 Links (21.78') #3

Robert A. Griffin R.L.S. #13584
LCRC #207 October 20, 1969
Set 5" Square reinforced concrete post 3' long with 3" diameter brass disk on top by using old witnesses from undated survey
9" Black Ash N25°E 72.66' #4
6" Maple N76°E 153.84' #5
3" Cherry S37°W 48.02' #6
4" X 7" Pine Post North 32.79' #7
Found stump #8
Dead but still standing #9

Undated Survey Notes from the Office of County Surveyor from
LCRC #207 Robert A. Griffin R.L.S. #13584
Monument Iron
4" Birch N43°E 83.9' #8
8" Elm S23°E 100.00' #9

B. DESCRIPTION OF CORNER EVIDENCE FOUND AND/OR METHOD APPLIED IN RESTORING OR REESTABLISHING CORNER:

Found cabin spike on top of Robert A. Griffin's monument in blacktop road and the centerline of the East and West road is 4 feet South and the condition of the recorded witnesses are: #1 thru #3 gone, #4 and #5 good condition, #6 gone, #7 good condition, #8 and #9 gone.

C. DESCRIPTION OF MONUMENT FOR CORNER AND ACCESSORIES ESTABLISHED TO PERPETUATE LOCATING THE POSITION OF THE CORNER:


Accepted cabin spike on top of Robert A. Griffin's concrete monument as a substantial marker for the section corner and is accepted as a careful and faithful reestablishment of the original corner.

12" Black Ash N25°E 72.92' Spike in East side of tree. #4
12" Maple N76°E 153.84' Spike in North side of tree. #5
4" X 4" Post North 32.79' Found nail and tag #13584 in East side of post. #7
10" Maple S30°W 61.73' Spike and tag in West side of tree.

Signed by Norman L. Ochs Date September 13, 1996

Surveyor's Michigan License No. 22439 Form approved by Michigan State Board of Land Surveyors, Jan 28, 1971

Approved by Peer Review Group On September 17, 1996
Norman L. Ochs, County Representative.

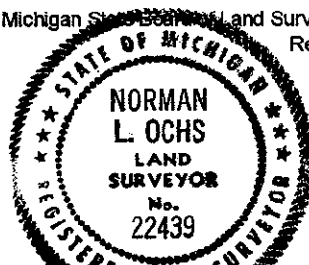

Revised May 14, 1975
Revised Jan., 1983