

## 1993 NEWAYGO COUNTY REMONUMENTATION PROJECT

COMMISSION

## LAND CORNER RECORDATION CERTIFICATE

Filing Requirement of Act 74, Mich. P.A. 1970

JAN 21 PM 3 28

For corners in

Newaygo (County) Located In: Corner Code #

1. Public Land Survey T<sup>16 N</sup> R<sup>14 W</sup> K-5  
 T R  
 T R  
 T R

2. Property Controlling S T R  
 in Section S T R

3. Miscellaneous S T R  
 Property in Sec. S T R

Marlene Toogood

VOL 001 PAGE 58

Register of Deeds Stamp &amp; File Number

4. Lot No. , Recorded Plat  
 5. Private Claims

I, Norman L. Ochs, in a field survey on December 6, 1993, do hereby certify that under requirements of P.A. 74, Michigan P.A. of 1970, the corner points mentioned in lines 1 and 2 above were in conformance with regulations and rules therefore as required in the current manual of survey instructions of the United States Department of the Interior, Bureau of Land Management or by a decree of a Court of Law and/or that the corner points mentioned in lines 3, 4 and 5 above were in conformance with the rules of the Michigan Board of Land Surveyors or by a Decree of a Court of Law; established, re-established, monumented, re-monumented, recovered, found as expressed below:

**NOTE: Not more than 4 corners, all in the same town and range, may be recorded on this certificate.**

A. Description of original monument and accessories and/or subsequent restoration:  
 K-5 - N.W. Corner, Section 13, Troy Township, Newaygo Co., Mi.

G.L.O.

#1 26" W. Pine S12°W 36 Links (23.76')

#2 18" Maple N73°E 71 Links (46.86')

Lyle S. Shepherd, LS #503

Field Book 65, Page 22

Found King Bolt

8/19/1969 - Robert A. Griffin, LS 13584

Found King Bolt in East & West Gravel Road in line with edge of field S.E. He replaced the King Bolt with a 5" x 36" Concrete post with a 3" diameter brass disc.

#3 15" R. Pine N55°E 44.00'

#4 4" Sq. x 7' Pine Post South 33.17'

#5 3" R. Pine S31°W 54.77'

#6 14" W. Pine N5°W 66.40'

(SEE OVER FOR CONTINUATION OF "A")

B. Description of corner evidence found and/or method applied in restoring or reestablishing corner:

K-5 - N.W. Corner, Section 13, Troy Township, Newaygo Co., Mi.

I found R.A. Griffin's concrete monument damaged and in poor condition. I replaced the damaged monument with a 4" Harrison cast iron monument. I measured a distance of 2612.0 feet to the N. 1/4 corner of Section 14, AND 5229.0 feet to the Northwest corner of Section 14. Condition of the recorded witnesses are: #1 Gone, #2 Gone, #3 Found in good condition, #4 Found in good condition, #5 Found in good condition, #6 Found in good condition, #7 Found in good condition, #8 Found in good condition, #9 Found a 14" Jack Pine Bearing N60°E 43.70' (dead), #10 Found in good condition.

C. Description of monument for corner and accessories established to perpetuate locating the position of the corner:

K-5 - N.W. Corner, Section 13, Troy Township, Newaygo Co., Mi.

I accepted the 4" Harrison cast iron monument as a substantial marker for the Section corner and is accepted as a careful and faithful re-establishment of the original corner.

15" R. Pine (dead) N55°E 44.01' (Spike in N.W. side of tree) (#3)

4" Sq. x 7' Pine Post South 33.17' (Spike in East side of post) (#4)

8" R. Pine S31°W 54.79' (Spike in East side of tree) (#5)

20" W. Pine N05°W 66.40' (Spike in West side of tree) (#6)

1/2" Rod South 33.00'

Signed by Norman L. Ochs 22439 Norman L. Ochs


Date December 15, 1993

Surveyor's Michigan License No. \_\_\_\_\_

Approved by Peer Review Group Dec. 27, 1993

Norman L. Ochs, County Representative

FORM APPROVED BY MICHIGAN STATE BOARD OF LAND SURVEYORS, JAN. 28, 1971  
 REVISED MAY 14, 1971  
 REVISED JAN. 1, 1993

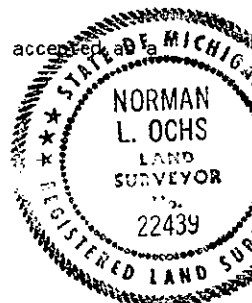

CONTINUATION OF "A" - LAND CORNER RECORDATION CERTIFICATE

October 26, 1976 - James Evans, LS 22431

Found 5" Square Concrete Monument and reported  
all of Griffin's accessories (#3 thru #6)

July 30, 1981, Anthony P. Kurzy, LS 14326

Monument not identified  
# 7 Fence Corner South 27.30'  
# 8 12" Pine S30°E 31.20'  
# 9 14" Pine N30°E 43.70'  
#10 10" Oak N30°W 26.0'