

COPY

LAND CORNER RECORDATION CERTIFICATE Filing Requirement of Act 74, Mich. P.A. 1970

For corners in

<u>Oakland</u>	Located in:	Corner Code #
(county)		
1. Public Land Survey	T1N R 8E	L-5
	T R	
	T R	
	T R	
2. Property Controlling	S T	R
in Section	S T	R
3. Miscellaneous	S T	R
Property in Sec.	S T	R

\$ 7.00 MISCELLANEOUS RECORDING
\$ 2.00 REMONUMENTATION
19 DEC 96 11:04 A.M. RECEIPT# 178
PAID RECORDED - OAKLAND COUNTY
LYNN D. ALLEN, CLERK/REGISTER OF DEEDS

Compliance with
ACT 345, P.A. 1970

APPROVED ON: 11-6-96
OAKLAND COUNTY REMONUMENTATION
TECH GROUP COMMITTEE

Register of Deeds Stamp & File Number

4. Lot No. _____, Recorded Plat _____

5. Private Claims _____

I, Joseph C. Kapelczak, in a field survey on September 7, 1995, do hereby certify that under requirements of P.A. 74, Michigan P.A. of 1970, the corner points mentioned in lines 1 and 2 above were in conformance with regulations and rules therefore as required in the current manual of survey instructions of the United States Department of the Interior, Bureau of Land Management or by a decree of a Court of Law and/or that the corner points mentioned in lines 3, 4 and 5 above were in conformance with the rules of the Michigan Board of Land Surveyors or by a Decree of a Court of Law; established, re-established, monumented, re-monumented, recovered, found as expressed below:

NOTE: Not more than 4 corners, all in the same town and range, may be recorded on this certificate.

A. Description of original monument and accessories and/or subsequent restoration:

Post set in 1816 G.L.O. Survey. No witness.
L.C.R.C. Kapelczak 1994 L.15423 P.129
Reset 1/2" rerod in monument box
N 45 E 67.62' set PK nail 1 ft. North of sidewalk
south edge in joint under center beam of bridge
S 30 E 48.40' chisled "+" in west side of concrete pillar,
under north bound westerly bridge
N 35 W 46.00' chisled "+" in northeast corner of C.B. in curb line
S 45 W 68.60' chisled "+" in east side of concrete pillar
under south bound most easterly pillar and bridge

L.C.R.C. Roon 1989 L.11057 P.819
1/2" Iron rod in monument box
N 40 W 45.57' nail 12" Apple
N 50 E 51.50' nail 13" Pine
S 63 E 68.03' nail 5" Locust
S 04 W 32.57' 5/8" Iron

	A	B	C	D	E	F	G	H	I	J	K	L
2												
3												
4												
5												
6												
7												
8												
9												
10												
11												
12												
13												

B. Description of corner evidence found and/or method applied in restoring or reestablishing corner:

Recovered 1/2" rerod in Monument box in concrete road.
No witnesses.

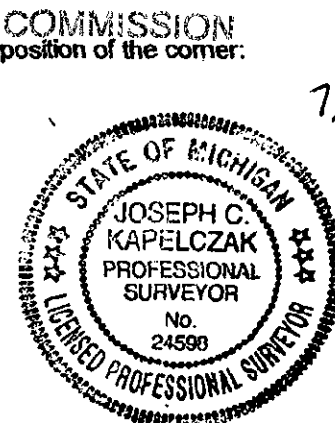
SURVEY &
REMONUMENTATION

MAY 22 1997

C. Description of monument for corner and accessories established to perpetuate locating the position of the corner:

Set remonumentation brass cap.

S 34 E 48.45' chisled "+" west side concrete pillar
S 45 W 68.49' chisled "+" east side concrete pillar
N 40 W 46.00' chisled "+" northeast corner catch basin
N 40 E 67.57' PK nail in concrete joint

Signed by Joseph C. KapelczakDate 11/6/96Surveyor's Michigan License No. 24598