

COPY

LAND CORNER RECORDATION CERTIFICATE
Filing Requirement of Act 74, Mich. P.A. 1970

For corners:

Oakland
(County)

Located in: West Bloomfield Township Corner Code #

1. Public Land Survey

T2N R9E B-7

2. Property Controlling in Section

S T R

3. Miscellaneous Property in Sec.

S T R

4. Lot No. _____ Recorded Plat _____ SECTION _____
5. Private Claims _____

I, Huston K. Kennedy, in a field survey on May 4, 1998, hereby state that under requirements of P.A. 74, Michigan P.A. of 1970, the corner points mentioned in lines 1 and 2 above were in conformance with regulations and rules therefore as required in the current manual of survey instructions of the United States Department of the Interior, Bureau of Land Management or by a decree of a Court of Law and/or that the corner points mentioned in lines 3, 4 and 5 above were in conformance with the rules of the Michigan Board of Land Surveyors or by a Decree of a Court of Law; established, re-established, monumented, recovered, found as expressed below:

NOTE: Not more than 2 corners, all in the same town and range, may be recorded on this certificate.

\$ 7.00 MISCELLANEOUS RECORDING
\$ 2.00 REMONUMENTATION
16 SEP 98 7:37 A.M. RECEIPT# 1A
PAID RECORDED - OAKLAND COUNTY
LYNN D. ALLEN, CLERK/REGISTER OF DEEDS

Compliance with
ACT 345, P.A. 1990

APPROVED ON: 9-16-98 JS
OAKLAND COUNTY REMONUMENTATION
PEER GROUP COMMITTEE

Register of Deeds Stamp & File Num

	A	B	C	D	E	F	G	H	I	J	K	L
1												
2		6		5		4		3		2		1
3												
4		7		8		9		10		11		12
5												
6		18		17		16		15		14		13
7												
8		19		20		21		22		23		24
9												
10		30		29		28		27		26		25
11												
12		31		32		33		34		35		36
13												

- A. Description of original monument and accessories and/or subsequent restoration:
1817-GLO Carpenter, D.S.; Set Post 12" Black Oak S41 1/4°W 147 1/3 Links; 12" White Oak N84 1/4°E 15 Links
1.) 1975-Jones, PS #2934; LCRC L.6200, Pg.607 - Fnd 3/8" Iron Rod
2.) 1986-Ward, PS #22445; LCRC L.9683, Pg.763 - Fnd a Monument
3.) 1986-Ward, PS #22445; Survey L.16288, Pg.511 - Fnd a Monument, used same wit as 1986 LCRC
4.) 1979-VanHorn, PS #25379; Unrecorded Survey - Fnd a 3/8" Rod, used same wit as 1975 LCRC

- B. Description of corner evidence found and/or method applied in restoring or reestablishing corner:
1998-Kennedy Surveying, Inc. - Kennedy, PS #17623 - Fnd a 4" diameter Concrete Monument with a 1/2" Iron Rod that is 0.30 feet below the road surface and in the existing centerline of Oakley Park Road extending to the East & West, which is gravel surface. A tree/fence line extending to the South.

Witnesses from LCRC #1, 2 & Survey #3 were used to recover and verify the location of the found 4" diameter Conk Monument with a 1/2" Iron Rod

I accepted the found 4" diameter Concrete Monument with a 1/2" Iron Rod as the best evidence of the original corner position


FIELD MEASUREMENTS BETWEEN

B-7 to A-7

GLO = 36 chains or 2376.00 Ft.
"TWIN BEACH GOLF & COUNTRY CLUB" (See 18) = 2403.25 Ft.
2401.74 Ft. (GPS-MEA)

B-7 to C-7

GLO = 40 chains or 2640.00 Ft.
Survey recorded in Liber 16288, page 46
"TWIN BEACH GOLF COUNTRY CLUB" (See 18) = 2637.94 Ft. (GPS-MEA)

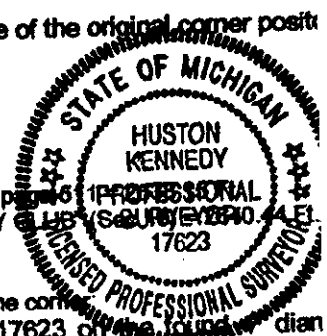

- C. Description of monument for corner and accessories established to perpetuate locating the position of the corner:
B-7 I placed a 2" diameter brass cap stamped Oakland County Remonumentation, PS #17623 on the found 4" diameter Concrete Monument with 1/2" Iron Rod
N46°E 31.28' Set Mag Nail & Remon Washer SE face 21" Ash
N54°W 58.14' Set Mag Nail & Remon Washer SW face 26" Cherry
S63°E 46.63' Set Mag Nail & Remon Washer North face 10" Oak
Due South 29.57' Set Mag Nail & Remon Washer East face 11" Oak
North 33.00', found 1/2" Iron Rod
North 43.10', found 4" diameter Concrete Monument

The selected location is accepted by me and is generally accepted by Professional Surveyors as the best available evidence of the position of the original corner.

Signed by: [Signature]
Surveyor's Michigan License No. 17623

Date 8-21-98